

LAND CORNER RECORDATION CERTIFICATE
Filing Requirement of Act 74, Mich. P.A. 1970 as Amended

For corners in

Houghton (County)	Located In:	Corner Code #
1. Public Land Survey	T _____ R _____	_____
	T _____ R _____	_____
	T _____ R _____	_____
2. Property Controlling in Section	S 8 T 55N R 33W	10
	S 8 T 55N R 33W	11
	S _____ T _____ R _____	_____
3. Miscellaneous Property in Sec.	S _____ T _____ R _____	_____
	S _____ T _____ R _____	_____
4. Lot No. _____, Recorded Plat		
5. Private Claims		

Register of Deeds Stamp & File Number

	A	B	C	D	E	F	G	H	I	J	K	L	M
1													
2	6		5		4		3		2		1		
3													
4	7		8		9		10		11		12		
5													
6	18		17		16		15		14		13		
7													
8	19		20		21		22		23		24		
9													
10	30		29		28		27		26		25		
11													
12	31		32		33		34		35		36		
13													

I, Stephan J. Szyszkoski, in a field survey on 10 06/15/2011 do hereby state
that under requirements of P.A. 74, Michigan P.A. of 1970, the corner points mentioned in lines 1 and 2
above were in conformance with regulations and rules therefore as required in the current manual of survey
instructions of the United States Department of the Interior, Bureau of Land Management or by a decree of
a Court of Law and /or that the corner points mentioned in lines 3, 4 and 5 above were in conformance with
the rules of the Michigan Board of Land Surveyors or by a Decree of a Court of Law; established,
re-established, monumented, recovered, found as expressed below:

NOTE: Not more than 2 corners, all in the same town and range, may be recorded
on this certificate.

A. Description of original monument and accessories and/or subsequent restoration:

(10-Sec. 8) South 1/16 corner between Sections 7 and 8. Previously monumented by R.S.Haataja PS
39478 midway and on line between Quarter corner C4 and Section corner C5.

(11-Sec. 8) Southwest 1/16 corner, Section 8. Not previously established.

B. Description of corner evidence found and/or method applied in restoring or reestablishing corner:

(10-Sec. 8) Found a 5/8" rebar with plastic cap stamped "R.Haataja PS39478" in good condition,
projecting about 6" above grade, and substantially midway and on the Section line between Quarter
corner C4, found 1303.27' north and Section corner C5 1303.01' south. C5 falls in Boston Pond. Its
position was computed from Houghton County Remonumentation records and monuments at C4 and its
reference corner 1171.72' north. See LCRC L4 - P248 and drawing Liber 3 of plats - P298B. Accepted
the 1/16 corner monument as a careful and faithful determination of the position of the corner.

(11-Sec. 8) Established the corner at the intersection of straight lines connecting opposite 1/16
corners. 1/16 corner #8 is described on a survey L2 - P229, #10 and #12 are recorded by the
undersigned, #15 falls in Boston Pond and is computed from Houghton County Remonumentation survey
Liber 3 of plats, Page 298B.

C. Description of monument for corner and accessories established to perpetuate locating the position of the corner:


(10) Fd. 5/8" capped rebar.
Set measuring nail with MDNR tag in the side of:
5" Tamarack N68E 17.45' mrkd "1/16S BT"
6" W.Birch S22E 7.05' do
7" W.Birch S60W 5.75' do
4" Balsam N15W 7.75' do
Set sq'd cedar post adjacent.
Bearings are magnetic.

(11) Set 1"IDx32" I.pipe with 4" alum. MDNR cap.
Set measuring nail with MDNR tag in the side of:
6" Sugar N55E 27.4' mrkd "1/16S BT"
5" Sugar S64E 12.95' do
5" Sugar S54W 17.15' do
16" Oak N60W 16.2' do
Set sq'd cedar post adjacent.
Bearings are magnetic.

Signed by Stephan J. Szyszkoski
Surveyor's Michigan License No. 33986

Date 10/26/2011

For the Michigan Department of Natural Resources, Forest Management Division

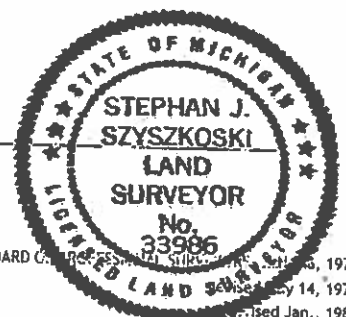

16732

16735