

LAND CORNER RECORDATION CERTIFICATE
Filing Requirement of Act 74, Mich. P.A. 1970 as Amended

For corners in

Houghton (County)	Located In:	Corner Code #
1. Public Land Survey	T R	
	T R	
	T R	
2. Property Controlling in Section	S 13 T 55N R 33W	1
	S 11 T 55N R 33W	C-S-SE 1/64
	S T R	
3. Miscellaneous Property in Sec.	S T R	
	S T R	
4. Lot No. _____, Recorded Plat		
5. Private Claims		

I, Stephan J. Szyszkoski, in a field survey on 1/64 07/26/2011 do hereby state that under requirements of P.A. 74, Michigan P.A. of 1970, the corner points mentioned in lines 1 and 2 above were in conformance with regulations and rules therefore as required in the current manual of survey instructions of the United States Department of the Interior, Bureau of Land Management or by a decree of a Court of Law and /or that the corner points mentioned in lines 3, 4 and 5 above were in conformance with the rules of the Michigan Board of Land Surveyors or by a Decree of a Court of Law; established, re-established, monumented, recovered, found as expressed below:

NOTE: Not more than 2 corners, all in the same town and range, may be recorded on this certificate.

A. Description of original monument and accessories and/or subsequent restoration:

(1-Sec. 13) West 1/16 corner between Sections 12 and 13. Found no record of prior monumentation.

(C-S-SE 1/64, Sec. 11) The SW corner of the NW1/4 of the SE1/4 of the SE1/4 of Section 11. Not previously established.

B. Description of corner evidence found and/or method applied in restoring or reestablishing corner:

(1-Sec. 13) Found no monumentation at the corner position. Established the corner midway and on the Section line between Section corner 1282.78' west and Quarter corner 1282.78' east.

(C-S-SE 1/64) Established the corner midway and on a straight line between 1/16 corners #13 and #16, 659.16' north and south.

C. Description of monument for corner and accessories established to perpetuate locating the position of the corner:

(1) Set 1"IDx32" I.pipe with 4" alum. MDNR cap.
Set measuring nail with MDNR tag in the side of:
6" Y.Birch S42E 13.2' mrkd "1/16S BT"
5" Maple S14E 25.4' do
19" Oak S67W 7.0' do
6" Y.Birch N36W 11.55' do
Set sq'd Cedar post adjacent.
Bearings are magnetic.

1/64 - Set 1"IDx32" I.pipe w/4" alum. MDNR cap.
Set measuring nail with MDNR tag in the side of:
13" Oak N52E 24.8' mrkd "1/64S BT"
7" Maple S73E 19.1' do
6" Maple S42W 20.45' do
6" Sugar N14W 33.35' do
Set sq'd cedar post adjacent.
Bearings are magnetic.


Register of Deeds Stamp & File Number

	A	B	C	D	E	F	G	H	I	J	K	L	M
1													
2	6	5								2			
3													
4	7	8								11			
5													
6	18	17	16	15	14	13							
7													
8	19	20	21	22	23	24							
9													
10	30	29	28	27	26	25							
11													
12	31	32	33	34	35	36							
13													

Signed by Stephan J. Szyszkoski
Surveyor's Michigan License No. 33986

Date 11/15/2011

For the Michigan Department of Natural Resources, Forest Management Division

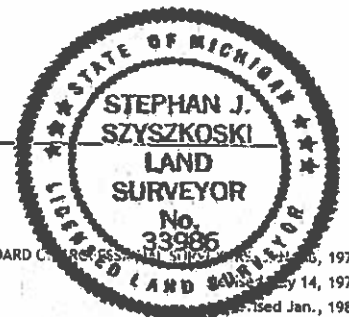

16766

16765

FORM APPROVED BY MICHIGAN STATE BOARD OF LAND SURVEYORS, 1971

Revised Jan., 1983

Revised Oct., 1995