

JAN 25 2000

LAND CORNER RECORDATION CERTIFICATE
Filing Requirement of Act 74, Mich. P.A. 1970

SECTION

For corners in
HOUGHTON
(County)

Located In:

Corner Code #

1. Public Land Survey

T 55N R 33W
T 55N R 33W
T _____ R _____
T _____ R _____

K-6

10 K-6(7) ✓

MARY SCHOOS 09/27/99

HOUGHTON COUNTY, REGISTER 10:12

LC 4/ 33 PAU Fee: 9.00

Page 1 of 1

2. Property Controlling
in Section

S _____ T _____ R _____
S _____ T _____ R _____

3. Miscellaneous

S _____ T _____ R _____

Property in Section

S _____ T _____ R _____

Register of Deeds Stamp & File Number

4. Lot No. _____, Recorded Plat _____

5. Private Claims _____

I, R.W. CRAMPTON, in a field survey on APRIL 20, 19 99,
do hereby certify that under requirements of P.A. 74, Michigan P.A. of 1970, the corner points mentioned
in lines 1 and 2 above were in conformance with regulations and rules therefore as required in the current
manual of survey instructions of the United States Department of the Interior, Bureau of Land
Management or by a decree of a Court of Law and/or that the corner points mentioned in lines 3, 4 and
5 above were in conformance with the rules of the Michigan Board of Professional Surveyors or by a
Decree of a Court of Law; established, re-established, monumented, re-monumented, recovered, found
as expressed below:


NOTE: Not more than 4 corners, all in the same town and range, may be recorded
on this certificate.

A. Description of original monument and accessories and/or subsequent restoration:

K-6, SET QUARTER SEC. POST, HEMLOCK 14 N26W 16, WHITE PINE 8 N41E 17.

10, INTERSECTED LAKE, CEDAR 4 FOR MEANDER CORNER, SUGAR 6 N4W 16.

	A	B	C	D	E	F	G	H	I	J	K	L	M
2	6		5		4		3		2		1		
3													
4	7		8		9		10		11		12		
5													
6	18		17		16		15		14		13		
7													
8	19		20		21		22		23		24		
9													
10	30		29		28		27		26		25		
11													
12	31		32		33		34		35		36		
13													

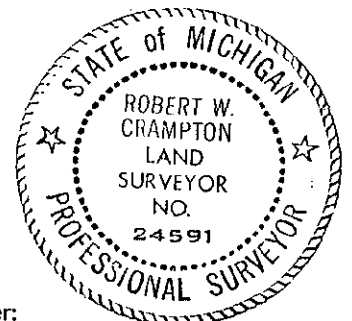

B. Description of corner evidence found and/or method applied in restoring or reestablishing corner:

K-6, FOUND 1/2" CAPPED PIN FROM ASSESSOR'S PLAT OF TAMARACK MILL (CABINET 2, FOLIO 132)
AND RECORDED LAND CORNER (LIBER 2, PAGE 575). REPLACE WITH 1" IRON PIPE WITH BRASS CAP.

10, SET 1" IRON PIPE WITH BRASS CAP BY EXTENDING THE LINE FROM THE NW 1/16 CORNER AND THE
W 1/4, SOUTH TO THE NORTHERLY RIGHT OF WAY LINE OF HIGHWAY M-26.

C. Description of monument for corner and accessories established to perpetuate locating the position of the corner:

K-6, THE 1" IRON PIPE WITH BRASS CAP WAS WITNESSED WITH SURVEY TAG NAILED TO:
6" MAPLE TREE N02°W 11.81', 18" OAK TREE N82°W 23.84',
14" POPLAR TREE S74°E 12.52', NORTH 236.18' TO 4" PLAT MONUMENT.

10, THE 1" IRON PIPE WITH BRASS CAP WAS WITNESSED WITH SURVEY TAG NAILED TO:
14" POPLAR TREE S78°W 38.85', 9" MAPLE TREE N58°W 40.50',
12" POPLAR TREE NORTH 78.72', 5" MAPLE TREE N18°E 34.72'.

Signed by Robert W. Crampton

Date SEPT. 23, 1999

Surveyor's Michigan License No. 24591