

SURVEY &  
REMONUMENTATION

JAN 21 1998

SECTION

LAND CORNER RECORDATION CERTIFICATE

Filing Requirement of Act 74, Mich. P.A. 1970

For corners in  
KEWEENAW  
(County)

Located In:

Corner Code #

1. Public Land Survey

56  
T 57N R 32W  
T 57N R 32W  
T 56 R \_\_\_\_\_  
T \_\_\_\_\_ R \_\_\_\_\_

D-13  
E-13

2. Property Controlling  
in Section

S \_\_\_\_\_ T \_\_\_\_\_ R \_\_\_\_\_  
S \_\_\_\_\_ T \_\_\_\_\_ R \_\_\_\_\_

3. Miscellaneous

S \_\_\_\_\_ T \_\_\_\_\_ R \_\_\_\_\_

Property in Section

S \_\_\_\_\_ T \_\_\_\_\_ R \_\_\_\_\_

4. Lot No. \_\_\_\_\_, Recorded Plat \_\_\_\_\_

5. Private Claims \_\_\_\_\_

REGISTER'S OFFICE

County of Keweenaw } SS  
Received for Record, the 29<sup>th</sup>  
day of July A.D. 1997  
at 10:00 o'clock A.M., and Recorded  
in Liber 1 of LCR  
on page 165  
Manly Whelan  
Register of Deeds

Register of Deeds Stamp & File Number

	A	B	C	D	E	F	G	H	I	J	K	L	M
2	0			5		4		3		2			
3													
4	7			8		9		10		11		12	
5													
6	18			17		16		15		14		13	
7													
8	19			20		21		22		23		24	
9													
10	30			29		28		27		26		25	
11													
12	31			32		33		34		35		36	
13													

I, R. W. CRAMPTON, in a field survey on JUNE 5, 19 85,  
do hereby certify that under requirements of P.A. 74, Michigan P.A. of 1970, the corner points mentioned  
in lines 1 and 2 above were in conformance with regulations and rules therefore as required in the current  
manual of survey instructions of the United States Department of the Interior, Bureau of Land  
Management or by a decree of a Court of Law and/or that the corner points mentioned in lines 3, 4 and  
5 above were in conformance with the rules of the Michigan Board of Professional Surveyors or by a  
Decree of a Court of Law; established, re-established, monumented, re-monumented, recovered, found  
as expressed below:


NOTE: Not more than 4 corners, all in the same town and range, may be recorded  
on this certificate.

A. Description of original monument and accessories and/or subsequent restoration:  
D-13 SOUTH 1/4 CORNER-SET POST-SPRUCE 7 N88E 30, BIRCH 12 N80W 44.  
E-13 SOUTHEAST CORNER-CEDAR 14 N76E 46, CEDAR 11 N78W 10.

Ratified by Peer Group  
In accordance with P.A. 345  
Co. Rep. James M. Stahel  
Date 7/29/97

B. Description of corner evidence found and/or method applied in restoring or reestablishing corner:

D-13 SOUTH 1/4 CORNER-1 1/2" IRON PIPE IN CONCRETE FOUND AND SET WITH 4" BRASS CAP.  
E-13 SOUTHEAST CORNER-2 1/2" IRON PIPE FOUND AND SET WITH 4" BRASS CAP.

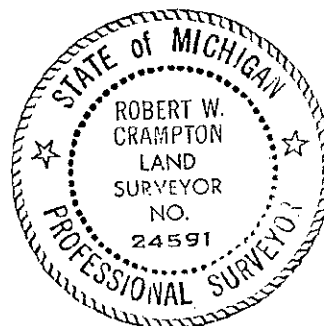

C. Description of monument for corner and accessories established to perpetuate locating the position of the corner:

D-13 THE 1 1/2" IRON PIPE WITH 4" BRASS CAP WAS WITNESSED WITH SURVEY TAG NAILED TO:  
4" ELM TREE N84 W 32.66', 5" ASH TREE N46 E 25.0',  
2" ALDER TREE S25 W 63.16', CUT OFF UTILITY POLE N88 E 11.16'.  
E-13 THE 2 1/2" IRON PIPE WITH 4" BRASS CAP WAS WITNESSED WITH SURVEY TAG NAILED TO:  
3" CHOKE CHERRY TREE N33 W 58.33', 3" CHOKE CHERRY TREE N85 E 24.05',  
5" PIN CHERRY TREE S4 W 38.37', 2" CEDAR TREE N88 W 49.20'.

Signed by Robert W. Crampton

Date JULY 22, 1997

Surveyor's Michigan License No. 24591