

SURVEY &
REMONUMENTATION

MAR 19 1997

COMMISSION

1996

REMONUMENTATION

Re - Mon Liber 1, Page 56

LAND CORNER RECORDATION CERTIFICATE
Filing Requirement of Act 74, Mich. P.A. 1970

For corners in Bingham Township

Huron County (County)	Located In:	Corner Code #
1. Public Land Survey	T15N R13E	C-13
	T R	
	T R	
	T R	
2. Property Controlling in Section	S T R	
	S T R	
3. Miscellaneous Property in Sec.	S T R	
	S T R	

STATE OF MICHIGAN
HURON COUNTY
RECORDED

7 NOV 96 4:08 P.M.

FRANCES L. HOLDWICK
REGISTER OF DEEDS

Register of Deeds Stamp & File Number

4. Lot No. _____, Recorded Plat _____
5. Private Claims _____

I, Russell L. Brown, in a field survey on Oct. 8, 1996 do hereby state that under requirements of P.A. 74, Michigan P.A. of 1970, the corner points mentioned in lines 1 and 2 above were in conformance with regulations and rules therefore as required in the current manual of survey instructions of the United States Department of the Interior, Bureau of Land Management or by a decree of a Court of Law and/or that the corner points mentioned in lines 3, 4 and 5 above were in conformance with the rules of the Michigan Board of Land Surveyors or by a Decree of a Court of Law; established, re-established, monumented, recovered, found as expressed below:

NOTE: Not more than 2 corners, all in the same town and range, may be recorded on this certificate.

	A	B	C	D	E	F	G	H	I	J	K	L	M
1													
2	6		5		4		3		2		1		
3													
4	7		8		9		10		11		12		
5													
6	18		17		16		15		14		13		
7													
8	19		20		21		22		23		24		
9													
10	30		29		28		27		26		25		
11													
12	31		32		33		34		35		36		
13													

A. Description of original monument and accessories and/or subsequent restoration:

1834 G.L.O. H. Parke D.S.
Set Post Corner Sections 31 and 32
Maple 12", N62E 28 Links
Maple 10", N49W 58 Links

County Surveyors Record:
NONE

(OVER)

County Road Commission Records:

T Iron
Centerline Road, West 27'
Southeast Corner Bridge Floor, S70°W 19.60'
Northeast Corner Bridge Floor, N80°W 16.30'
24" Maple, N50°W 128.0'
Power Pole, Nail and Cap, N60°E 124.00'

B. Description of corner evidence found and/or method applied in restoring or reestablishing corner:

Found 1" Pipe over "T" Iron, 3'± 4'± North of centerline gravel road East and West, 30'± East of centerline gravel road South, in line with centerline gravel road extended South from the North, 3'± below surface.

Accepted: Found 1" Pipe over "T" Iron as the best evidence of the original location of corner C-13.


C. Description of monument for corner and accessories established to perpetuate locating the position of the corner:

Corner Sections 31 and 32, T15N-R13E C-13

Found 1" Pipe over "T" Iron

WITNESSES:

N50°W 113.85' to Spike in Northeast Side 10" Elm Tree
S45°W 44.18' Found "+" in Southwest End of Southeasterly 108"± C.M.P.
S35°E 72.95' to Spike in Northeast Side 10" Ash Tree
N45°E 48.62' to Spike in Southeast Side Wood Corner Post
N12°W 26.87' to "+" in Northeasterly End of Southeasterly 108"± C.M.P.

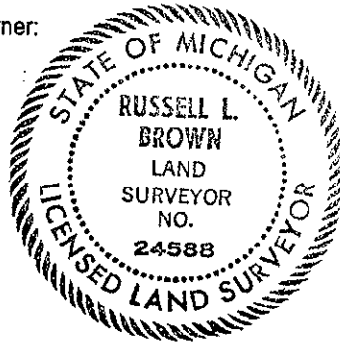

Signed by Russell L. Brown

Date 11-05-96

Surveyor's Michigan License No. 24588

PEER GROUP APPROVED

AT MEETING 11-05-96

FORM APPROVED BY MICHIGAN STATE BOARD OF PROFESSIONAL SURVEYORS, JAN. 28, 1971

REVISED MAY 14, 1975

REVISED JAN., 1983

REVISED OCT. 1985

Liber 1, Page 56 A

December 7, 1972- Act 74 L.C.R.C. Liber 1, Page 2 of Huron County Records.

"T" Iron

N80°W 16.30' to Northeast Corner Bridge Floor

S70°W 19.60' to Southeast Corner Bridge Floor

N60°E 124.00' to Nail and Cap in Power Pole

West 27' to Centerline Road South

October 21, 1992 Act 74 L.C.R.C. Liber 1, Page 102 of Huron County Records.

"T" Iron

S69°W 44.09' Found "+" in Southerly end of Easterly C.M.P.

N70°E 124.76' to N and S in Power Pole

N33°W 33.33' to 1/2" Rod

July 2, 1992 Survey by Sheridan Surveying Co. (Job No: 9206.351).

Same monument and accessories as 10-21-92 Act 74 L.C.R.C., Liber 1, Page 102 of Huron County Records.

September 25, 1992 Survey by Sheridan Surveying Company (Job No: 9206.351).

"T" Bar, raised with 1" Pipe

West 5.94' to 1/2" Steel Stake (Northwest Corner Section 5, T14N-R13E)

S05°E 76.26' to Spike in East Side 8" Ash Tree

S45°W 44.10' to Chiseled "+" in Southwest End 10' C.M.P.

\$ 2.00 MSSR
\$ 9.00 SURVEY