

**SURVEY &
REMONUMENTATION**

MAR 19 1997

Re - Mon Liber 1, Page 63

COMMISSION 1996 REMONUMENTATION

LAND CORNER RECORDATION CERTIFICATE
Filing Requirement of Act 74, Mich. P.A. 1970

For corners in Bingham Township

Huron County (County)	Located In:	Corner Code #
1. Public Land Survey	T15N R 13E	J-13
	T ___ R ___	_____
	T ___ R ___	_____
	T ___ R ___	_____
2. Property Controlling in Section	S ___ T ___ R ___	_____
	S ___ T ___ R ___	_____
3. Miscellaneous Property in Sec.	S ___ T ___ R ___	_____
	S ___ T ___ R ___	_____

STATE OF MICHIGAN
HURON COUNTY
RECORDED

7 NOV 96 4:10 P.M.

FRANCES L. HOLDWICK
REGISTER OF DEEDS

Register of Deeds Stamp & File Number

4. Lot No. _____, Recorded Plat _____
5. Private Claims _____

I, Russell L. Brown, in a field survey on Oct. 7, 1996 do hereby state that under requirements of P.A. 74, Michigan P.A. of 1970, the corner points mentioned in lines 1 and 2 above were in conformance with regulations and rules therefore as required in the current manual of survey instructions of the United States Department of the Interior, Bureau of Land Management or by a decree of a Court of Law and /or that the corner points mentioned in lines 3, 4 and 5 above were in conformance with the rules of the Michigan Board of Land Surveyors or by a Decree of a Court of Law; established, re-established, monumented, recovered, found as expressed below:

NOTE: Not more than 2 corners, all in the same town and range, may be recorded on this certificate.

	A	B	C	D	E	F	G	H	I	J	K	L	M
1													
2		6		5		4		3		2		1	
3													
4		7		8		9		10		11		12	
5													
6		18		17		16		15		14		13	
7													
8		19		20		21		22		23		24	
9													
10		30		29		28		27		26		25	
11													
12		31		32		33		34		35		36	
13													

A. Description of original monument and accessories and/or subsequent restoration:

1834 G.L.O., H. Parke, D.S. County Road Commission Records
Set quarter Section Post, Iron Pin
Cedar 9", N77°E 5 links Spike in Fence Post due South 21.35'
Cedar 14", N69 1/2W, 16 Links

County Surveyor Records: Act 74 Form:
NONE NONE

Recorded Surveys:
NONE

B. Description of corner evidence found and/or method applied in restoring or reestablishing corner:

Found 3/4" Dia. Steel Stake, approximate centerline gravel road in line with fence South.

Accepted: Found 3/4" Steel Stake as best evidence of original corner position for Corner J-13.


C. Description of monument for corner and accessories established to perpetuate locating the position of the corner:

S. 1/4 Corner of Section 35, T15N-R13E J-13

Found 3/4" Steel Stake

WITNESSES:

N45°W 61.89' to Spike in Northeast Side 12" Poplar Tree
S35°W 29.22' to P.K. Nail in Northwest Corner Railroad Tie Gate Post
S05°W 22.74' to P.K. Nail in East Side of Railroad Tie Gate Post
N05°E 50.89' to Spike in East Side 9" Poplar Tree

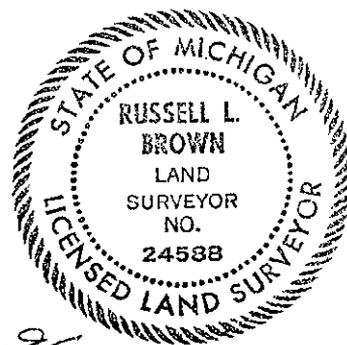

Signed by Russell L. Brown

Date 11-05-96

Surveyor's Michigan License No. 24588

PEER GROUP APPROVED

AT MEETING 11-05-96.