

JAN 19 2001

2000 REMONUMENTATION

Re-Mon Liber 2, Page 77

SECTION

LAND CORNER RECORDATION CERTIFICATE
Filing Requirement of Act 74, Mich. P.A. 1970

For corners in

Huron

(County)

Located In:

Corner Code #

1. Public Land Survey Sherman T15N R16E A-4
T R
T R
T R
2. Property Controlling S T R
in Section S T R
3. Miscellaneous S T R
Property in Sec. S T R

STATE OF MICHIGAN
HURON COUNTY
RECORDED

20 SEP 2000 2:05 PM

FRANCES L. HOLDWICK
REGISTER OF DEEDS

Register of Deeds Stamp & File Number

4. Lot No. , Recorded Plat
5. Private Claims

I, Charles S. Getz, in a field survey on May 10, 2000 do hereby state that under requirements of P.A. 74, Michigan P.A. of 1970, the corner points mentioned in lines 1 and 2 above were in conformance with regulations and rules therefore as required in the current manual of survey instructions of the United States Department of the Interior, Bureau of Land Management or by a decree of a Court of Law and/or that the corner points mentioned in lines 3, 4 and 5 above were in conformance with the rules of the Michigan Board of Land Surveyors or by a Decree of a Court of Law; established, re-established, monumented, recovered, found as expressed below.

NOTE: Not more than 2 corners, all in the same town and range, may be recorded on this certificate.

1	A	B	C	D	E	F	G	H	I	J	K	L	N
2		6		5		4		3		2		1	
3													
4	7		8		9		10		11		12		
5													
6	16		17		16		15		14		13		
7													
8	19		20		21		22		23		24		
9													
10	30		29		28		27		26		25		
11													
12	31		32		33		34		35		36		
13													

A. Description of original monument and accessories and/or subsequent restoration:

A-4 1834 G.L.O., H. Parke D.S. County Road Commission Records - Iron Pin
Set quarter section post
W. Ash 12", S34½°W, 29 Links Recorded Surveys - Brown, 8-22-78, Liber 3, Page 676, 1" Bar
Cedar 9", N25°W, 20 Links Unrecorded Surveys - Brown, 12-30-87, 1" Bar

L.C.R.C. - NONE


County Surveyor Records -
NONE

B. Description of corner evidence found and/or method applied in restoring or reestablishing corner:

A-4
W 1/4 Cor, Section 7, T15N-R16E
Found 1" Iron Bar
Accepted as the best available evidence
of the original corner position
(On Edwards Road)

C. Description of monument for corner and accessories established to perpetuate locating the position of the corner:

A-4
W 1/4 Cor, Section 7, T15N-R16E
Found 1" Iron Bar
N80°E 52.50' to Nail in Power Pole
East 32.75' to Nail in Fence Post
West 34.35' to Nail in Fence Post
S70°E 36.85' to Nail in Power Pole
West 33.0' to 1/2" Iron Bar
South 2637.31' to SW Cor, Sec 7, T15N-R16E
North 2633.66' to NW Cor, Sec 7, T15N-R16E

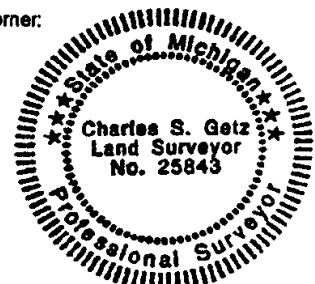

Signed by Charles S. Getz

Date June 3, 2000

Surveyor's Michigan License No. 25843

PEER GROUP APPROVED AT MEETING
HELD September 18, 2000. RLB