

SURVEY &
REMONUMENTATION

JAN 22 1998

1997 REMONUMENTATION

LAND CORNER RECORDATION CERTIFICATE
Filing Requirement of Act 74, Mich. P.A. 1970

STATE OF MICHIGAN
HURON COUNTY
RECORDED

12 DEC 97 12:41 P.M.

FRANCES L. HOLDWICK
REGISTER OF DEEDS

Register of Deeds Stamp & File Number

SECTION

For corners in COLFAX TOWNSHIP

HURON

(County)

Located In:

Corner Code #

1. Public Land Survey

T16NR 12E

G-13

T R

T R

T R

T R

2. Property Controlling
in Section

S

T R

S

T R

3. Miscellaneous
Property in Sec.

S

T R

S

T R

4. Lot No. , Recorded Plat

5. Private Claims

I, Russell L. Brown, in a field survey on Nov. 24 19 97 do hereby state that under requirements of P.A. 74, Michigan P.A. of 1970, the corner points mentioned in lines 1 and 2 above were in conformance with regulations and rules therefore as required in the current manual of survey instructions of the United States Department of the Interior, Bureau of Land Management or by a decree of a Court of Law and /or that the corner points mentioned in lines 3, 4 and 5 above were in conformance with the rules of the Michigan Board of Land Surveyors or by a Decree of a Court of Law; established, re-established, monumented, recovered, found as expressed below:

NOTE: Not more than 2 corners, all in the same town and range, may be recorded on this certificate.

	A	B	C	D	E	F	G	H	I	J	K	L	M
1													
2	6			5			4		3		2		1
3													
4	7			8			9		10		11		12
5													
6	18			17			16		15		14		13
7													
8	19			20			21		22		23		24
9													
10	30			29			28		27		26		25
11													
12	31			32			33		34		35		36
13													

A. Description of original monument and accessories and/or subsequent restoration:

1834 G.L.O. H. Parke D.S. Set Post Corner Sections 33 and 34

Pine 36 N67 1/2W 17 Cedar 12 N69E 21

COUNTY SURVEYORS RECORDS: 1888 survey by Duncan McFadden County Surveyor, Survey of part of Section 34, T16N-R12E, Quarter Section Post set equal distance from the Section Corners No accessories given.

COUNTY ROAD COMMISSION: Ford Axle in Cedar Post N65E 71.70' Spike in 10" Maple

S45°E 53.45' Spike in S.W. Base T.P., N45°E 43.45' Spike in 18" Maple

S45°W 47.50' Spike in N.W. Base Cor. Post, N50°W 49.95' Spike in 18" Elm

N45°W 68.70' Spike in N.E. Base P.P. (OVER)

B. Description of corner evidence found and/or method applied in restoring or reestablishing corner:

No evidence of original corner or accessories found.

Found Axle Shaft in Wood Post.

Accepted found Axle Shaft in Wood Post as best evidence of original corner position.

C. Description of monument for corner and accessories established to perpetuate locating the position of the corner:

G-13 Corner Sections 33 and 34, T16N-R12E,

Found Axle Shaft in Wood Post, raised with 3/4" x 14" Pipe capped 24588

WITNESSES:

N45°W 75.78' to P.K. Nail in N.E. Side P.P.

N30°E 54.67' to 1/2" x 18" Steel Stake

S65°E 52.60' to 1/2" x 18" Steel Stake

S65°W 50.57' to 1/2" x 18" Steel Stake

East 2632.42' to S. 1/4 Corner Section 34, T16N-R12E H-13

West 2625.46' to S. 1/4 Corner Section 33, T16N-R12E F-13

Signed by Russell L. Brown

Date December 9, 1997


Surveyor's Michigan License No. 24588

PEER GROUP APPROVED

AT MEETING HELD

DEC 11, 1997

D / R

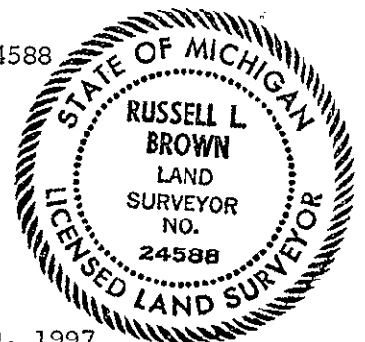

Re-Mon Liber 1 Page 139(A)

ACT 74 FORM: None

RECORDED SURVEYS: July 10, 1973 Survey Recorded in Liber 1, Page 502 of Huron County
Records: S.G. Case P.S. 15399.

Axle Shaft in Cedar Post in Place

Spike in S.E. Side of P.P., N35°E 56.65'

Spike in N.E. Side of P.P., N50°E 68.85'

Spike in S.W. Side of T.P., S50°E 53.48'