

SURVEY &  
REMONUMENTATION

JAN 22 1998

1997 REMONUMENTATION

Re-Mon - Liber 1 Page 137

SECTION

LAND CORNER RECORDATION CERTIFICATE  
Filing Requirement of Act 74, Mich. P.A. 1970

For corners in COLFAX TOWNSHIP

HURON Located In: Corner Code #  
(County)

1. Public Land Survey T16N R12E I-13  
T R  
T R  
T R

2. Property Controlling S T R  
in Section S T R

3. Miscellaneous S T R  
Property in Sec. S T R

STATE OF MICHIGAN  
HURON COUNTY  
RECORDED

12 DEC 97 12:41 P.M.

FRANCES L. HOLDWICK  
REGISTER OF DEEDS

Register of Deeds Stamp & File Number

4. Lot No. , Recorded Plat  
5. Private Claims

I, Russell L. Brown, in a field survey on Nov. 24, 1997 do hereby state that under requirements of P.A. 74, Michigan P.A. of 1970, the corner points mentioned in lines 1 and 2 above were in conformance with regulations and rules therefore as required in the current manual of survey instructions of the United States Department of the Interior, Bureau of Land Management or by a decree of a Court of Law and/or that the corner points mentioned in lines 3, 4 and 5 above were in conformance with the rules of the Michigan Board of Land Surveyors or by a Decree of a Court of Law; established, re-established, monumented, recovered, found as expressed below:

NOTE: Not more than 2 corners, all in the same town and range, may be recorded on this certificate.

	A	B	C	D	E	F	G	H	I	J	K	L	M
1													
2	6		5		4		3		2		1		
3													
4	7		8		9		10		11		12		
5													
6	18		17		16		15		14		13		
7													
8	19		20		21		22		23		24		
9													
10	30		29		28		27		26		25		
11													
12	31		32		33		34		35		36		
13													

- A. Description of original monument and accessories and/or subsequent restoration:  
1834 G.L.O. H. Parke D.S., Set Post Corner Sections 34 and 35.  
Maple 11 N49E 52, B. Ash 7" N65W 32 1/2  
COUNTY SURVEYORS RECORDS: 1888 Survey by Duncan McFadden, County Surveyor, survey of part of Section 34, T16N-R12E, Corner reestablished from witness trees. No object or accessories given.  
COUNTY ROAD COMMISSION RECORDS: 8-18-94 Mark B. Plotter and Robert Damrow, Huron County Road Commission Survey department. Found Wood Post, Set 5/8" Re-Rod in Center, WITNESSES: N60°E 61.93' to P.K. Nail in P.P., S20°E 66.40' to Spike in 16" Twin Ash  
S45°E 48.81' to Spike in Fence Post  
(OVER)
- B. Description of corner evidence found and/or method applied in restoring or reestablishing corner:  
No evidence of original corner or accessories found.  
Accepted Found 5/8" Re-Rod in Wood Post as best evidence of original corner position.

- C. Description of monument for corner and accessories established to perpetuate locating the position of the corner:  
I-13 Corner Sections 34 and 35, T16N-R12E  
Found 5/8" Re-Rod in Wood Post  
WITNESSES:  
N50°E 61.92' to P.K. Nail in W. Side P.P.  
S50°E 43.63' to Notch in South End 18" C.M.P.  
S40°W 38.85' to Southwest Corner Concrete Wall  
N45°W 40.02' to 1/2" x 18" Steel Stake  
West 2.15' to 1/2" Re-Rod in Wood Post, apparent Corner Sections 2 and 3, T15N-R12E  
East 2634.62' to S. 1/4 Corner Section 35, T16N-R12E, J-13  
West 2633.01' to S. 1/4 Corner Section 34, T16N-R12E, H-13


Signed by Russell L. Brown Date December 9, 1997

Surveyor's Michigan License No. 24588

PEER GROUP APPROVED  
AT MEETING HELD

DEC. 11, 1997.

RLB

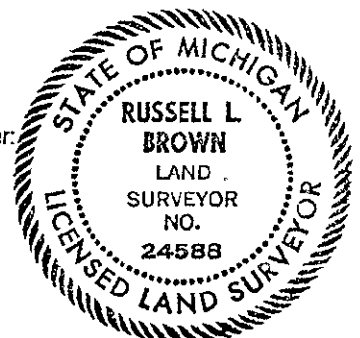

Re-Mon - Liber 1 Page 137 (A)

Act 74 FORM: None

RECORDED SURVEYS: 1,31,80 Survey by S.G. Case, P.S. 15399, recorded in Liber 4, on Page 262 of Huron County Records.

1/2" Steel Pin in Place

WITNESSES:

P.K. Nail in face of P.P., N65°E 63.75'

Nail in face of Corner Fence Post, S45°E 49.9'

Nail in W. Side 25" Twin Ash Tree, S20°E 66.50'