

JAN 19 2001

SECTION

2000 REMONUMENTATION
LAND CORNER RECORDATION CERTIFICATE
Filing Requirement of Act 74, Mich. P.A. 1970

For Corners in CASEVILLE Township

Huron
(County)

Located in:

Corner Code #

- | | | | |
|-------------------------|---|-------------|---|
| 1. Public Land Survey | | T 18N R 10E | 1 |
| | | T — R — | |
| | | T — R — | |
| | | T — R — | |
| 2. Property Controlling | S | T — R — | |
| in Section | S | T — R — | |
| 3. Miscellaneous | S | T — R — | |
| Property in Sec. | S | T — R — | |

STATE OF MICHIGAN
HURON COUNTY
RECORDED

8 DEC 2000 9:56 AM


FRANCES L. HOLDWICK
REGISTER OF DEEDS

Register of Deeds Stamp & File Number

4. Lot No. _____, Recorded Plat _____
5. Private Claims _____

I, Russell L. Brown, in a field survey on October 12, 2000 do hereby state that under requirements of P.A. 74, Michigan P.A. of 1970, the corner points mentioned in lines 1 and 2 above were in conformance with regulations and rules therefore as required in the current manual of survey instructions of the United States Department of the Interior, Bureau of Land Management or by a decree of a Court of Law and/or that the corner points mentioned in lines 3, 4, and 5 above were in conformance with the rules of the Michigan Board of Land Surveyors or by a Decree of a Court of Law; established, re-established, monumented, recovered, found as expressed below:

NOTE: Not more than 2 corners, all in the same town and range, may be recorded on this certificate.

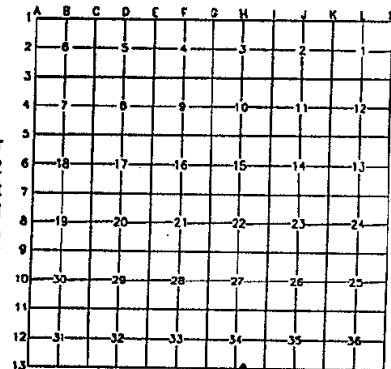

A. Description of original monument and accessories and/or subsequent restoration:

GLO H. Parke D.S. Set post on the border of Saginaw Bay
Pine 26 S2W 39; DO 30 N59 1/2E 80
COUNTY SURVEYOR RECORD: None
COUNTY ROAD COMMISSION RECORD: None
L.C.R.C.: None
RECORDED SURVEYS: None
UNRECORDED SURVEYS: None
RECORDED PLATS: None

B. Description of corner evidence found and/or method applied in restoring or reestablishing corner:

No evidence of original corner or accessories found.

Set 1/2" x 18" Steel Stake (Re-Rod) capped 24588 G.L.O. distance (2310.0') West of I-13.

C. Description of monument for corner and accessories established to perpetuate locating the position of the corner:

1. Meander Corner, border Saginaw Bay between T17&18N-R10E

Set 1/2" x 18" Steel Stake (Re-Rod) capped 24588

WITNESSES:


S16°W 65.15' to Nail in East Side 8" White Birch

S30°E 40.70' to Nail in Northeast Side 12" deciduous tree

S60°E 75.92' to Nail in North Side 14" deciduous tree

N55°E 89.45' to Nail in center 10" White Birch Stump

East 2310.00' to I-13, S. Cor. Section 34 and 35, T18N-R10E

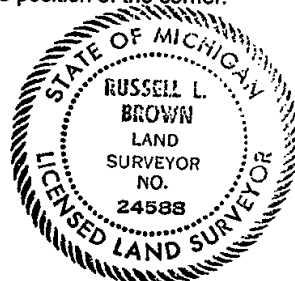

Signed by Russell L. Brown
Surveyor's Michigan License No. 24588

Date Nov. 2, 2000

Peer group approved at meeting held November 2, 2000. RAB