

ACCEPTED BY THE HILLSDALE COUNTY SURVEY PEER GROUP AS THE OFFICIAL CORNER UNDER MICHIGAN PUBLIC ACT 345 OF 1990 AT MEETING HELD ON 11-28-94 AL RINGENBERG, CO. REP.

LIBER 3 PAGE 75 97913
REMONUMENTATION

RECORDED
HILLSDALE CO. MICH.

LAND CORNER RECORDATION CERTIFICATE
Filing Requirement of Act 74, Mich. P.A. 1970

'94 DEC 14 AM 11 59

Judy VanZandt
REG. OF DEEDS

For corners in

1. Public Land Survey
2. Property Controlling in Section
3. Miscellaneous Property in Sec.
- Located In: Hillsdale (County)
Corner Code # F-1 I-4
- T 5S R 1W
T R
T R
T R
S T R
S T R
S T R

SURVEY &
REMONUMENTATION

APR 27 1995 Register of Deeds Stamp & File Number

4. Lot No. , Recorded Plat
5. Private Claims
- COMMISSION

	A	B	C	D	E	F	G	H	I	J	K	L	M
2	6		5		4		3		2		1		
3													
4	7		8		9		10		11		12		
5													
6	18		17		16		15		14		13		
7													
8	19		20		21		22		23		24		
9													
10	30		29		28		27		26		25		
11													
12	31		32		33		34		35		36		
13													

I, John E. Maxson, in a field survey on 4 November, 1994, do hereby certify that under requirements of P.A. 74, Michigan P.A. of 1970, the corner points mentioned in lines 1 and 2 above were in conformance with regulations and rules therefore as required in the current manual of survey instructions of the United States Department of the Interior, Bureau of Land Management or by a decree of a Court of Law and/or that the corner points mentioned in lines 3, 4 and 5 above were in conformance with the rules of the Michigan Board of Land Surveyors or by a Decree of a Court of Law; established, re-established, monumented, re-monumented, recovered, found as expressed below:

NOTE: Not more than 4 corners, all in the same town and range, may be recorded on this certificate.

A. Description of original monument and accessories and/or subsequent restoration:


- F-1
GLO did not set this Corner
- I-4
GLO, 1824, 12" B. Oak, NOSE, 31 lks
7" W. Oak, S57.5W, 21 lks
LCRC, 1979, Keller, L1, P619
3/4" Iron w/cap (Suydam)
VanGieson Survey, 1982, L1, P825
3/4" Pipe
LCRC, 1986, VanGieson, L2, P69
Set 3/4" Pipe at midpoint

B. Description of corner evidence found and/or method applied in restoring or reestablishing corner:

- F-1
No evidence of this Corner was found. Reset this corner from the Plat of "HIGHLAND HILLS" as the best available position of the original Corner
- I-4
Found iron from Keller LCRC and accepted as the best available evidence of the position of the original Corner. Also found 3/4" Pipe from VanGieson LCRC app. 37 feet South of Keller Iron to be used as property controlling Corner

C. Description of monument for corner and accessories established to perpetuate locating the position of the corner:

- F-1
Reset 5/8 x 36 rebar w/cap
South 2.00' C. Line Vicary Rd.
South 33.26' 42" Oak
S48W 35.03' 5" Cherry
S39E 41.31' P. Pole
N22E 34.59' Stop Sign Post
- I-4
Reset 5/8 x 36 rebar w/cap
S02E 48.75' Fence Post
N02E 4.95' Fence Post
N10W 119.70' P. Pole
West 49.38' 4" Maple
South 37.44' 3/4" Pipe, Prop. Cont. Cor. from LCRC, L2, P69

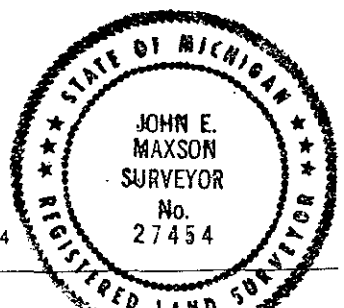

Signed by John E. Maxson
Surveyor's Michigan License No. 27454

Date 12 December, 1994