

ACCEPTED BY THE HILLSDALE COUNTY  
SURVEY PEER GROUP AS THE OFFICIAL  
CORNER UNDER MICHIGAN PUBLIC ACT 345  
OF 1990 AT MEETING HELD ON  
11-28-94  
AL RINGENBERG, CO. REC.

LIBER 3 PAGE 74  
REMONUMENTATION

97912

RECORDED  
HILLSDALE CO. MICH.

'94 DEC 14 AM 11 59

Judy VanZandt  
REG. OF DEEDS

LAND CORNER RECORDATION CERTIFICATE  
Filing Requirement of Act 74, Mich. P.A. 1970

For corners in

HILLSDALE  
(County)

Located In: Corner Code #

1. Public Land Survey T 5S R 1W F3,  
T R  
T R  
T R  
2. Property Controlling S T R  
in Section S T R  
3. Miscellaneous S T R  
Property in Sec. S T R

SURVEY &  
REMONUMENTATION

APR 27 1995

Register of Deeds Stamp & File Number

COMMISSION

4. Lot No. , Recorded Plat  
5. Private Claims

I, John E. Maxson, in a field survey on 4 November, 1994,  
do hereby certify that under requirements of P.A. 74, Michigan P.A. of 1970, the corner points mentioned  
in lines 1 and 2 above were in conformance with regulations and rules therefore as required in the  
current manual of survey instructions of the United States Department of the Interior, Bureau of Land  
Management or by a decree of a Court of Law and/or that the corner points mentioned in lines 3, 4 and 5  
above were in conformance with the rules of the Michigan Board of Land Surveyors or by a Decree of a  
Court of Law; established, re-established, monumented, re-monumented, recovered, found as  
expressed below:

NOTE: Not more than 4 corners, all in the same town and range, may be recorded  
on this certificate.

A. Description of original monument and accessories and/or subsequent restoration:

F-3  
GLO, 1824, 12"W.Oak, N35.5W, 63 lks  
10"W.Oak, S72E, 50 lks  
12"B.Oak, S68E, 75 lks  
Standard Corner West 190 lks  
VanGieson Survey, 1987, L558, P848  
1/2" Pipe

B. Description of corner evidence found and/or method applied in restoring or reestablishing corner:


F-3  
This corner is now under water.  
Reestablished position from the Plat  
of "INDIAN HILLS NO. 1" as the best  
available position of the original Corner

C. Description of monument for corner and accessories established to perpetuate locating the position of the corner:

F-3  
In water, no monument set  
389°30'25"E 2683.47' Ref. Mon. #1  
5/8" Rebar w/cap  
G-3, T5S-R1W  
500°54'43"E 1747.83' Ref. Mon. #2  
Con. Plat Mon.

Witnesses to Ref. Mon #2  
Con. Plat Mon. at NE Cor. Lot #85  
S22W 36.18' Basketball Pole  
N29W 91.64' SW Cor. Hse #11502  
North 2.35' P.Pole

	A	B	C	D	E	F	G	H	I	J	K	L	M
2	6		5		4		3		2		1		
3													
4	7		8		9		10		11		12		
5													
6	18		17		16		15		14		13		
7													
8	19		20		21		22		23		24		
9													
10	30		29		28		27		26		25		
11													
12	31		32		33		34		35		36		
13													

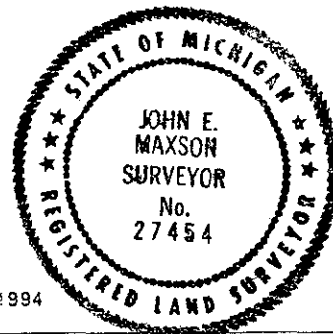

Signed by John E. Maxson  
Surveyor's Michigan License No. 27454

Date 12 December, 1994