

ACCEPTED BY THE HILLSDALE COUNTY
SURVEY PEER GROUP AS THE OFFICIAL
CORNER UNDER MICHIGAN PUBLIC ACT 348
OF 1990 AT A MEETING HELD ON
11-10-94
AL RINGENBERG, CO. REP.

LIBER 3 PAGE 76

97914

RECORDED
HILLSDALE CO. MICH.

REMONUMENTATION

LAND CORNER RECORDATION CERTIFICATE

'94 DEC 14 AM 11 59

Filing Requirement of Act 74, Mich. P.A. 1970

Judy VanZandt
REG. OF DEEDS

For corners in

HILLSDALE
(County)

Located In:

Corner Code #

1. Public Land Survey

T 5S R 1W

F5 G3

T R

T R

T R

T R

2. Property Controlling
in Section

S T R

S T R

3. Miscellaneous
Property in Sec.

S T R

S T R

SURVEY &
REMONUMENTATION

APR 27 1995

Register of Deeds Stamp & File Number

COMMISSION

4. Lot No. , Recorded Plat

5. Private Claims

	A	B	C	D	E	F	G	H	I	J	K	L	M
2	6	5	4	3	2	1							
3													
4	7	8	9	10	11	12							
5													
6	18	17	16	15	14	13							
7													
8	19	20	21	22	23	24							
9													
10	30	29	28	27	26	25							
11													
12	31	32	33	34	35	36							
13													

I, John E. Maxson, in a field survey on 4 November 19 94
do hereby certify that under requirements of P.A. 74, Michigan P.A. of 1970, the corner points mentioned
in lines 1 and 2 above were in conformance with regulations and rules therefore as required in the
current manual of survey instructions of the United States Department of the Interior, Bureau of Land
Management or by a decree of a Court of Law and/or that the corner points mentioned in lines 3, 4 and 5
above were in conformance with the rules of the Michigan Board of Land Surveyors or by a Decree of a
Court of Law; established, re-established, monumented, re-monumented, recovered, found as
expressed below:

NOTE: Not more than 4 corners, all in the same town and range, may be recorded
on this certificate.

A. Description of original monument and accessories and/or subsequent restoration:


F-5	G-3
GLO, 1824, 10"W.Oak, S50E, 61 lks	GLO, 1824, 14"B.Oak, S72E, 30 lks
16"W.Oak, South, 69 lks	14"B.Oak, S33W, 33 lks
LCRC, 1978, Berning, L1, P576	LCRC, 1986, VanGieson, L2, P71
Stone	3/4" Pipe

B. Description of corner evidence found and/or method applied in restoring or reestablishing corner:

F-5	G-3
Found stone from Berning LCRC	Found iron from Vangieson LCRC
and accepted as the best available	and accepted as the best available
evidence of the position of the	evidence of the position of the
original Corner	original Corner

C. Description of monument for corner and accessories established to perpetuate locating the position of the corner:

F-5	G-3
Reset 5/8 x 36 rebar w/cap	Reset 5/8 x 36 rebar w/cap
N51E 33.9' 10"Hickory	N50E 85.93' 12"Cherry
S32E 35.2' 20"Hickory	S10W 64.02' 12"Pine
S80W 28.4' 10"Ash	N45W 33.85' 36"Haulie
N22W 34.2' 30"Oak	N15W 68.20' 30"Maple

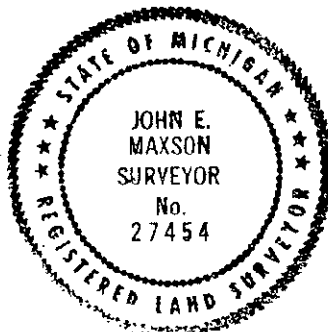

Signed by John E. Maxson

Date 12 December, 1994

Surveyor's Michigan License No. 27454