

123931

RECORDED
HILLSDALE CO. MICH.

'97 JUL 11 PM 2 48

Judy VanZandt
REG. OF DEEDS

LIBER 3 PAGE 179

HILLSDALE COUNTY REMONUMENTATION CORNER
LAND CORNER RECORDATION CERTIFICATE
Filing Requirement of Act 74, Mich. P.A. 1970

For corners in

HILLSDALE Located In: Corner

Code #

(County)

WHEATLAND TWP.

1. Public Land Survey	T 6 S R 1 W	I-5
	T R	
	T R	
	T R	
2. Property Controlling	S T R	
in Section	S T R	
3. Miscellaneous	S T R	
Property in Sec.	S T R	

Register of Deeds Stamp & File Number

4. Lot No. , Recorded Plat
5. Private Claims

I, EDWARD W. REED, in a field survey on MAY 2, 1997 do hereby state that under requirements of P.A. 74, Michigan P.A. of 1970, the corner points mentioned in lines 1 and 2 above were in conformance with regulations and rules therefore as required in the current manual of survey instructions of the United States Department of the Interior, Bureau of Land Management or by a decree of a Court of Law and /or that the corner points mentioned in lines 3, 4 and 5 above were in conformance with the rules of the Michigan Board of Land Surveyors or by a Decree of a Court of Law; established, re-established, monumented, recovered, found as expressed below:

NOTE: Not more than 2 corners, all in the same town and range, may be recorded on this certificate.

	A	B	C	D	E	F	G	H	I	J	K	L	M
1													
2		6		5		4		3		2		1	
3													
4		7		8		9		10		11		12	
5													
6		18		17		16		15		14		13	
7													
8		19		20		21		22		23		24	
9													
10		30		29		28		27		26		25	
11													
12		31		32		33		34		35		36	
13													

A. Description of original monument and accessories and/or subsequent restoration:
CORNER COMMON TO SECTIONS 10-11-14-15

1990: JOHN MAXSON, RLS, FOUND 3"X3"X10" ROCK 2' BELOW GRADE, SET IRON WITH CAP # 27454, RECORDED IN LCRC # 614/650

SURVEY &
REMONUMENTATION

FEB 11 1998

B. Description of corner evidence found and/or method applied in restoring or reestablishing corner:

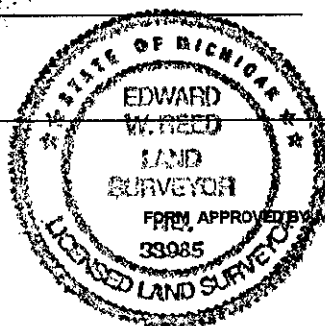
FOUND 1/2" IRON ROD WITH CAP 27454 SET OVER STONE

SECTION

C. Description of monument for corner and accessories established to perpetuate locating the position of the corner:
SET 3/4"X30" REBAR IRON AND REMON CAP IN CI-MONUMENT BOX OVER STONE 4" BELOW ROAD GRADE

T. POLE, N47W 73.74'
36" OAK N77W 128.01'
T. POLE S28E 62.19'
TEL. POLE N47W 73.74'
SET PK NAIL AT ALL POINTS

AND IS ACCEPTED AS A CAREFUL AND FAITHFUL PERPETUATION OF THE POSITION OF THE ORIGINAL CORNER

Signed by Edward W. Reed
EDWARD W. REEDDate MAY 2, 1997Surveyor's Michigan License No. 33985REVISED JAN., 198
REVISED OCT., 199