

1993

LIBER 3 PAGE 17

COMMISSION

REMONUMENTATION
LAND CORNER RECORDATION CERTIFICATE
Filing Requirement of Act 74, Mich. P.A. 1970

88319

RECORDED
HILLSDALE CO. MICH.

'93 DEC 22 PM 2 20

For corners in
Hillsdale

(County)

Located In:

Corner Code ##

1. Public Land Survey

T 6S. R 3W. T-8

T R

T R

T R

2. Property Controlling
in Section

S T R

S T R

3. Miscellaneous

S T R

Property in Sec.

S T R

4. Lot No. , Recorded Plat

5. Private Claims

Judy Vornzandt
REG. OF DEEDS

Register of Deeds Stamp & File Number

Frederick J.

I, Cutcher, in a field survey on December 22, 19 93,
do hereby certify that under requirements of P.A. 74, Michigan P.A. of 1970, the corner points mentioned
in lines 1 and 2 above were in conformance with regulations and rules therefore as required in the
current manual of survey instructions of the United States Department of the Interior, Bureau of Land
Management or by a decree of a Court of Law and/or that the corner points mentioned in lines 3, 4 and 5
above were in conformance with the rules of the Michigan Board of Land Surveyors or by a Decree of a
Court of Law, established, re-established, monumented, re-monumented, recovered, found as
expressed below:

**NOTE: Not more than 4 corners, all in the same town and range, may be recorded
on this certificate.**

	A	B	C	D	E	F	G	H	I	J	K	L	M
2	6	5	4	3	2	1							
3													
4	7	8	9	10	11	12							
5													
6	18	17	16	15	14	13							
7													
8	19	20	21	22	23	24							
9													
10	30	29	28	27	26	25							
11													
12	31	32	33	34	35	36							
13													

A. Description of original monument and accessories and/or subsequent restoration:

LCR dated Nov. 22, 1971 by A. John Hatt and recorded in Liber 1, Page 59:


Hatt found a 3/8" iron pipe that was found by Max Walter, M.S.H.D. Survey Chief
and used on previous and subsequent surveys in area. Iron pipe was removed in repaving
of Hillsdale St. but witnesses were take before repaving.

Hatt set a P.K. Nail.

B. Description of corner evidence found and/or method applied in restoring or reestablishing corner:

On this date I found a R.R. Spike with punch mark fitting most of the references
given by A. John Hatt in LCR Nov. 22, 1971, Liber 1, Page 59.

Obviously P.K. Nail was replaced with R.R. Spike by a local surveyor.

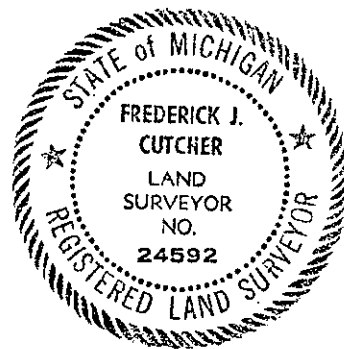

C. Description of monument for corner and accessories established to perpetuate locating the position of the corner:

Replaced R. R. Spike with 3/4" x 36" steel rod with cap (County issue) in monument box.
Fire Hydrant N 45° E 41.87'
P.K. Nail in N.W. side of Pwr. Pole S 40° W 35.70'
Nail in 36" Oak N 80° W 77.7'
Center of Gate Well cover S 40° W 5.60'
Center of Gate Well cover N 35° W 28.30'

And is accepted as a careful and faithful reestablishment of the position of the
original corner.

Signed by Frederick J. Cutcher

Date

December 22, 1993

Surveyor's Michigan License No.

24592