



HILLSDALE COUNTY REMONUMENTATION  
LAND CORNER RECORDATION CERTIFICATE  
Filing Requirement of Act 74, Mich. P.A. 1970

022235  
RECORDED  
HILLSDALE CO. MICH.

99 SEP -2 AM 9:15

Judy VanZandt  
REG. OF DEEDS

For corners in

HILLSDALE  
(County)  
ALLEN TWP.

Located In:

Corner Code #

1. Public Land Survey
- T R
- T R
- T R
- T R
2. Property Controlling in Section
- S 6 T 6S R4W B-1
- S T R
3. Miscellaneous Property in Sec.
- S T R
- S T R

Register of Deeds Stamp & File Number

4. Lot No. , Recorded Plat

5. Private Claims

I, Frederick J. Cutcher, in a field survey on July 26, 1999 do hereby state that under requirements of P.A. 74, Michigan P.A. of 1970, the corner points mentioned in lines 1 and 2 above were in conformance with regulations and rules therefore as required in the current manual of survey instructions of the United States Department of the Interior, Bureau of Land Management or by a decree of a Court of Law and /or that the corner points mentioned in lines 3, 4 and 5 above were in conformance with the rules of the Michigan Board of Land Surveyors or by a Decree of a Court of Law; established, re-established, monumented, recovered, found as expressed below:

NOTE: Not more than 2 corners, all in the same town and range, may be recorded on this certificate.

	A	B	C	D	E	F	G	H	I	J	K	L	M
1													
2		6		5		4		3		2		1	
3													
4		7		8		9		10		11		12	
5													
6		18		17		16		15		14		13	
7													
8		19		20		21		22		23		24	
9													
10		30		29		28		27		26		25	
11													
12		31		32		33		34		35		36	
13													


A. Description of original monument and accessories and/or subsequent restoration:

G.L.O.: No information, this North 1/4 Post was not set in original G.L.O.

Survey No. 755, 11/8/1876, Geo. A. Mark: Stake (no references)

B. Description of corner evidence found and/or method applied in restoring or reestablishing corner:

As there was virtually no information on this corner, I proportioned measured distance to GLO distance between Corner A-1, Allen Township and corner B-13 Litchfield Township, and set corner B-1 a distance of 68.27 feet West of B-13 Litchfield Township (B-13 Litchfield was found).

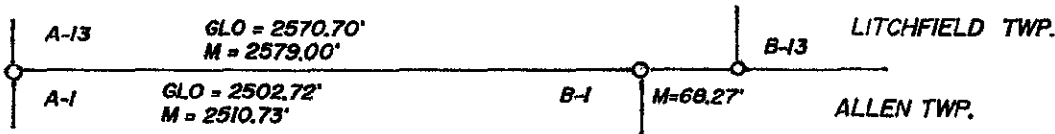

C. Description of monument for corner and accessories established to perpetuate locating the position of the corner.

Set 3/4" diameter iron with County Remonumentation Cap in monument box. This position was not established by original GLO. This corner is accepted as the best available evidence of the position of the corner.

In centerline Jonesville Road, 68.27' West of B-13, Litchfield Twp.; nail & spotter 12" Hickory N. 15° W. 30.22'; nail & spotter 18" Oak S. 30° W. 35.40'; top cen. tel. stan. N. 65° E. 69.42'; nail & spotter 18" Oak S. 13° E. 36.69'.

Signed by Frederick J. Cutcher  
Surveyor's Michigan License No. 24592



Date 7/30/99