

LIBER 3 PAGE 175

123927 RECORDED  
HILLSDALE CO. MICH.  
'97 JUL 11 PM 2 47

HILLSDALE COUNTY REMONUMENTATION CORNER  
LAND CORNER RECORDATION CERTIFICATE  
Filing Requirement of Act 74, Mich. P.A. 1970

Quincy Wanzan  
REC. OF DEEDS

For corners in

HILLSDALE	Located In:	Corner
Code #		
(County)		
ALLEN TWP.		
1. Public Land Survey	T 6 S R 4 W	G-6
	T R	
	T R	
	T R	
2. Property Controlling	S T R	
in Section	S T R	
3. Miscellaneous	S T R	
Property in Sec.	S T R	

Register of Deeds Stamp & File Number

4. Lot No. , Recorded Plat  
5. Private Claims

I, EDWARD W. REED, in a field survey on JUNE 26, 1997, do hereby state that under requirements of P.A. 74, Michigan P.A. of 1970, the corner points mentioned in lines 1 and 2 above were in conformance with regulations and rules therefore as required in the current manual of survey instructions of the United States Department of the Interior, Bureau of Land Management or by a decree of a Court of Law and for that the corner points mentioned in lines 3, 4 and 5 above were in conformance with the rules of the Michigan Board of Land Surveyors or by a Decree of a Court of Law; established, re-established, monumented, recovered, found as expressed below:

NOTE: Not more than 2 corners, all in the same town and range, may be recorded on this certificate.

	A	B	C	D	E	F	G	H	I	J	K	L	M
1													
2	6		5		4		3		2		1		
3													
4	7		8		9		10		11		12		
5													
6	18		17		16		15		14		13		
7													
8	19		20		21		22		23		24		
9													
10	30		29		28		27		26		25		
11													
12	31		32		33		34		35		36		
13													

A. Description of original monument and accessories and/or subsequent restoration:  
QUARTER CORNER COMMON TO SECTIONS 15-16

1974: DAVID BOONE, RLS- FOUND STONE IN ROAD DOWN 0.5'  
RECORDED IN LCRC LIBER 1/407

SURVEY &  
REMONUMENTATION

FEB 11 1998

B. Description of corner evidence found and/or method applied in restoring or reestablishing corner:

SECTION

FOUND 1/2" X 18" REBAR IRON FITTING ONE WITNESS OF BOONE, DID NOT FIND STONE

C. Description of monument for corner and accessories established to perpetuate locating the position of the corner:  
SET 3/4" X 30" REBAR IRON, REMON CAP IN CI-MONUMENT 4" BELOW ROAD GRADE


P.K. NAIL W. SIDE 8" CHERRY S45W 41.84'  
MAG NAIL S. SIDE P. POLE, S70E 33.95'  
MAG NAIL N SIDE P. POLE, WEST 44.60'  
COR. TEL PED., S78W 24.76'  
SE COR. GARAGE N12W 192.85'

AND IS ACCEPTED AS A CAREFUL AND FAITHFUL PERPETUATION OF THE POSITION OF THE ORIGINAL CORNER

Signed by Edward W. Reed Date JUNE 26, 1997

EDWARD W. REED

Surveyor's Michigan License No. 33985

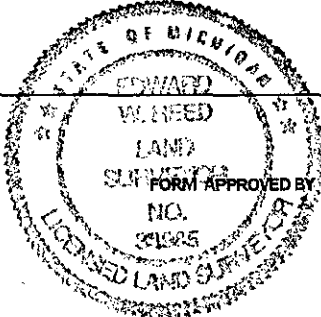

FORM APPROVED BY: MICHIGAN STATE BOARD OF PROFESSIONAL SURVEYORS, JAN. 28  
REVISED MAY 14, 1975

REVISED JAN., 198  
REVISED OCT., 199