



LIBER 5 PAGE 48

035916

RECORDED
HILLSDALE CO. MICH.

00 NOV 13 AM 11:09

HILLSDALE COUNTY REMONUMENTATION
LAND CORNER RECORDATION CERTIFICATE
Filing Requirement of Act 74, Mich. P.A. 1970Judy VanZandt
REG. OF DEEDS

For corners in

HILLSDALE

(County)

PITTSFORD TWP.

Located in:

Corner Code #

1. Public Land Survey

T7S R1W H-7

T R

T R

T R

2. Property Controlling
in Section

S T R

S T R

3. Miscellaneous
Property in Sec.

S T R

S T R

SURVEY &
REMONUMENTATION

JAN 12 2001

SECTION

Register of Deeds Stamp & File Number

4. Lot No. , Recorded Plat

5. Private Claims

I, Frederick J. Cutcher, in a field survey on Oct. 22, 2000 do hereby state that under requirements of P.A. 74, Michigan P.A. of 1970, the corner points mentioned in lines 1 and 2 above were in conformance with regulations and rules therefore as required in the current manual of survey instructions of the United States Department of the Interior, Bureau of Land Management or by a decree of a Court of Law and for that the corner points mentioned in lines 3, 4 and 5 above were in conformance with the rules of the Michigan Board of Land Surveyors or by a Decree of a Court of Law; established, re-established, monumented, recovered, found as expressed below:

NOTE: Not more than 2 corners, all in the same town and range, may be recorded on this certificate.

	A	B	C	D	E	F	G	H	I	J	K	L	M
1													
2	6		5		4		3		2		1		
3													
4	7		8		9		10		11		12		
5													
6	10		17		16		15		14		13		
7													
8	19		20		21		22		23		24		
9													
10	30		29		28		27		26		25		
11													
12	31		32		33		34		35		36		
13													

A. Description of original monument and accessories and/or subsequent restoration:

GLO, Robert Clark, Jr., 1824: Set Quarter Section Post at average distance; Beech 12" S. 25° E. 17 lks.; Beech 7" N. 20° E. 24 lks.

Geo. Mark, Mar. 17, 1871, Survey #597: Stone & Brick.

LCRC L.2, P. 68, Oct. 8, 1985, Glenn Richard, P.S. #13040: Set R.R. spike on line with section corners and in line with old fence South; Tel. Pole N. 50° E. 75.89'; 6" Walnut S. 30° E. 51.12'; Tel. Pole South 50.03'; Well casing S. 40° W. 99.38'

Description of corner evidence found and/or method applied in restoring or reestablishing corner:

Found R.R. Spike in centerline M-34. Old fence South is gone. No fence or occupation North. Well and Walnut references remain and check. Both tel. poles have been replaced.

C. Description of monument for corner and accessories established to perpetuate locating the position of the corner:

Replaced R.R. Spike with 3/4" x 30" Iron with remonumentation cap in monument box and is accepted as the best available evidence of the position of the original corner.

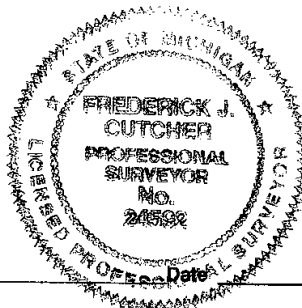
In centerline M-34; no occupation to North or South.

Nail & spotter 10" Walnut S. 22° E. 50.77'

Nail & spotter Tel. Pole South 49.74'

Top cen. well casing S. 40° W. 99.70'

Top cen. tel. stan. N. 50° E. 75.25'

Signed by Frederick J. Cutcher

Date

11/9/2000

Surveyor's Michigan License No.

24592