



LIBER 3 PAGE 35

97376

RECORDED
HILLSDALE CO. MICH.

'94 NOV 28 AM 11 07

Judy VanZandt
REG. OF DEEDS

REMONUMENTATION
LAND CORNER RECORDATION CERTIFICATE
Filing Requirement of Act 74, Mich. P.A. 1970

For corners in:

Hillsdale
(County)

Located In:

Corner Code #

1. Public Land Survey T 7S R 2W
T R
T R
T R
2. Property Controlling S T R
in Section S T R
3. Miscellaneous S T R
Property in Sec. S T R

E-2
SURVEY &
REMONUMENTATION

APR 27 1995

Register of Deeds Stamp & File Number

COMMISSION

4. Lot No. , Recorded Plat
5. Private Claims

	A	B	C	D	E	F	G	H	I	J	K	L	M
2	6		5		4		3		2		1		
3													
4	7		8		9		10		11		12		
5													
6	18		17		16		15		14		13		
7													
8	19		20		21		22		23		24		
9													
10	30		29		28		27		26		25		
11													
12	31		32		33		34		35		36		
13													

Frederick J.

Cutcher

November 7

94

I, , In a field survey on , 19 ,
do hereby certify that under requirements of P.A. 74, Michigan P.A. of 1970, the corner points mentioned
in lines 1 and 2 above were in conformance with regulations and rules therefore as required in the
current manual of survey instructions of the United States Department of the Interior, Bureau of Land
Management or by a decree of a Court of Law and/or that the corner points mentioned in lines 3, 4 and 5
above were in conformance with the rules of the Michigan Board of Land Surveyors or by a Decree of a
Court of Law; established, re-established, monumented, re-monumented, recovered, found as
expressed below:

NOTE: Not more than 4 corners, all in the same town and range, may be recorded
on this certificate.

A. Description of original monument and accessories and/or subsequent restoration:

Survey #685, Apr. 15, 1874, R. Bullard, County Surveyor: Stone, glass, brick, earthen;
W. Oak 32" N. 31° W., 59 links.

Survey #1081, Mar. 29, 1889, R.J. Coryell: Stone, brick & glass; W. Oak stump 32" N. 31° W.,
59 links.


R. Cole, LCRC Liber 1, Page 529, Dec. 1, 1975: Set 1/2"x30" rod with 1609 tag.

B. Description of corner evidence found and/or method applied in restoring or reestablishing corner:

Found 3/8"x31 1/2" iron rod. Dug down to sand, nothing else found. Replaced iron rod found
with 3/4"x36" County remonumentation bar and is accepted as a careful and faithful
reestablishment of the position of the original corner.

C. Description of monument for corner and accessories established to perpetuate locating the position of the corner:

3/4"x36" County remonumentation bar
5' East of centerline of gravel road
S.W. corner addition house #2519, N. 74° E., 53.15'
Found P.K. nail N. side 24" Hickory, S. 58° E., 29.31'
Top center well, N. 81° E., 41.53'
Nail in N. side 12" Cherry, West 32.98'
Nail in E. side 18" Oak, N. 30° W., 62.16'

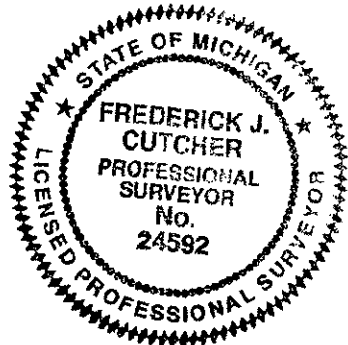

Signed by Frederick J. Cutcher

Date November 27, 1994

Surveyor's Michigan License No. 24592