

ACCEPTED BY THE HILLSDALE COUNTY SURVEY PEER GROUP AS THE OFFICIAL CORNER UNDER MICHIGAN PUBLIC ACT 345 OF 1970 - AT A MEETING HELD ON 12-28-95  
AL RINGENBERG, CO. REP.

LIBER 3 PAGE 111  
REMONUMENTATION  
LAND CORNER RECORDATION CERTIFICATE  
Filing Requirement of Act 74, Mich. P.A. 1970

107804 RECORDED  
HILLSDALE CO. MICH.  
'95 DEC 21 PM 3 41

Gregory VanZandt  
REG. OF DEEDS

SURVEY &  
MONUMENTATION

JAN 30 1996  
Register of Deeds Stamp & File Number

For corners in

HILLSDALE  
(County)

Located In: Corner Code #

1. Public Land Survey	T	7s	R	2W	J-5
	T		R		
	T		R		
	T		R		
2. Property Controlling in Section	S		T	R	
	S		T	R	
3. Miscellaneous Property in Sec.	S		T	R	
	S		T	R	
4. Lot No. _____, Recorded Plat _____					
5. Private Claims _____					

COMMISSION

	A	B	C	D	E	F	G	H	I	J	K	L	M
2	6		5		4		3		2		1		
3													
4	7		8		9		10		11		12		
5													
6	18		17		16		15		14		13		
7													
8	19		20		21		22		23		24		
9													
10	30		29		28		27		26		25		
11													
12	31		32		33		34		35		36		
13													

I, JOHN MAXSON, in a field survey on 28 NOVEMBER, 19 95, do hereby certify that under requirements of P.A. 74, Michigan P.A. of 1970, the corner points mentioned in lines 1 and 2 above were in conformance with regulations and rules therefore as required in the current manual of survey instructions of the United States Department of the Interior, Bureau of Land Management or by a decree of a Court of Law and/or that the corner points mentioned in lines 3, 4 and 5 above were in conformance with the rules of the Michigan Board of Land Surveyors or by a Decree of a Court of Law; established, re-established, monumented, re-monumented, recovered, found as expressed below:

NOTE: Not more than 4 corners, all in the same town and range, may be recorded on this certificate.

A. Description of original monument and accessories and/or subsequent restoration:


- |   |   |  |
|---|---|--|
| 1825 GLO WILLIAM BROOKFIELD<br>POST<br>S31E 17 lks 28" R.OAK<br>S74W 12 lks 9" IRONWOOD   | 1973 DONALD OLMSTEAD<br>LCRC L1 P253<br>FOUND STONE<br>NW 39.30 14" TREE<br>NE 37.43' ANCHOR POST<br>SW 36.80' 30" COTTONWOOD<br>SOUTH 33.00' IRON<br>SE 27.35' 24" ASH | 1974 JOHN HATT<br>SURVEY L1 P399<br>R.R. SPIKE OVER STONE<br>S70W 32.84' 18" OAK<br>N40W 37.30' 14" HICKORY<br>S40E 36.18' 18" OAK |
| 1867, 1869, 1881 GEORGE MARK<br>STONE, STAKE, BRICK EARTHEN<br>N58E 27.5 lks 30" W.OAK<br>NORTH 1 lks 4" HICKORY<br>NORTH 50 lks IRON |   |  |

B. Description of corner evidence found and/or method applied in restoring or reestablishing corner:

FOUND IRON W/CAP NEXT TO STONE WHICH FITS WITH OCCUPATION, ALSO MATCHES SURVEY DONE BY JOHN HATT. ACCEPTED AS A CAREFUL AND FAITHFUL PERPETUATION OF THE POSITION OF THE ORIGINAL CORNER.

C. Description of monument for corner and accessories established to perpetuate locating the position of the corner:

- SET 5/8" x 36" REBAR W/CAP
- S72W 55.75' 40" HICKORY  
S11W 27.87' 30" HICKORY  
N62W 37.15' 10" PINE  
N12W 36.80' STOP SIGN

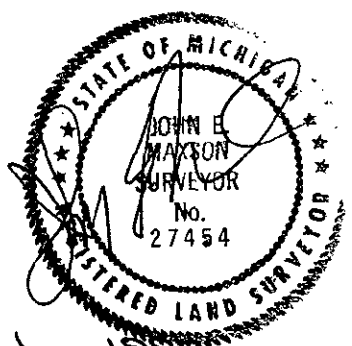

Signed by John E Maxson Date 21 December 1995  
Surveyor's Michigan License No. 27454