
034006

RECORDED MILESDALE CO. MICH.

## 00 SEP 14 AM 11:35

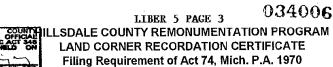

Gray Dangens

For corners in			REG. OF DEEDS	
HILLSDALE COUNTY Located In: Corner Code #			SURVEY &	
1. Public Land Survey	T <u>7S</u> R <u>4W</u> TR	G-5	EMONUMENTA JAN 1 2 200	
	TR		SECTION Register of Deeds Sta	ımp & File Number
3. Miscellaneous S T  Property in Sec. S T				
4. Lot No, Recorded	d Plat		-	
5. Private Claims			A B C D E F G	H I J K L
1, <u>FDWARD W. REED</u> , in a under requirements of P.A. 74, Mich and 2 above were in conformance wi manual of survey instructions of the Management or by a decree of a Cou 3, 4 and 5 above were in conformance by a Decree of a Court of Law; e as expressed below:	igan P.A. of 1970, the corner th regulations and rules therefor United States Department of t irt of Law and /or that the corn ce with the rules of the Michiga	points mentioned in lines 1 e as required in the current he Interior, Bureau of Land er points mentioned in lines in Board of Land Surveyors	4 7 8 9	-101112
NOTE: Not more than 2 comers, all in the same town and range, may be recorded on this certificate.			10 30 29 28	272625
CORNER COMMON TO SECTIONS 9, 10, 15 AND 16			12 31 32 33	343536-
A. Description of original monur restoration: 1825: WM BROOKFIELD, CORN 1872: GEO MARKS - BRICK ANI	er set	r subsequent	13	
B. Description of corner evidence	ce found and/or method app	lied in restoring or rees	tablishing corner	
FOUND IRON BENT OVER STON SET 3/4" x 30" IRON AT ANGLE	IE AND BRICK			FACE
C. Description of monument for	corner and accessories esta	ablished to perpetuate l	ocating the position of the	corner:
TAG IN EAST SIDE OF POWER F TAG IN TOP CENTER OF ROUND TAG IN TOP CENTER OF ROUND NORTH END OF NORTH - SOUT NORTHEAST CORNER OF TELEF	O WOOD ANCHOR POST O WOOD ANCHOR POST H ROAD CULVERT	N39°W 42.18' S45°E 46.71' S47°W 48.25' N61°E 39.8' S57°W 42.36'	W.	WARD REED AND IVEYOR
AND IS ACCEPTED AS A CAREF OF THE POSITION OF THE ORIG	FUL AND FAITHFUL PERPET	<b>FUATION</b>	<b>5</b> 71	NO. 3985 AND SUPPLED
Signed by Allus	Why		DATED: AUG	SUST 17, 2000
EDWARD W. REE	ט			

Surveyor's Michigan License No. 33985