


034017

LIBER 5 PAGE 14

RECORDED
HILLSDALE CO. MICH.

CO SEP 14 AM 11:36

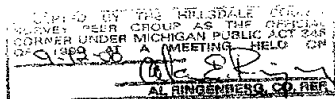

HILLSDALE COUNTY REMONUMENTATION PROGRAM

LAND CORNER RECORDATION CERTIFICATE

Filing Requirement of Act 74, Mich. P.A. 1970

Justy Conjunct
REG. OF DEEDS

For corners in

HILLSDALE COUNTY Located in: Corner Code #
READING TWP

1. Public Land Survey T 7 S R 4 W M-5
T R
T R
T R
2. Property Controlling S T R
in Section S
T R
3. Miscellaneous S
T R
Property in Sec. S
T R

4. Lot No. , Recorded Plat 5. Private Claims

I, EDWARD W. REED, in a field survey on AUGUST 17, 2000, do hereby state that under requirements of P.A. 74, Michigan P.A. of 1970, the corner points mentioned in lines 1 and 2 above were in conformance with regulations and rules therefore as required in the current manual of survey instructions of the United States Department of the Interior, Bureau of Land Management or by a decree of a Court of Law and /or that the corner points mentioned in lines 3, 4 and 5 above were in conformance with the rules of the Michigan Board of Land Surveyors or by a Decree of a Court of Law; established, re-established, monumented, recovered, found as expressed below:

NOTE: Not more than 2 corners, all in the same town and range, may be recorded on this certificate.

SOUTHEAST CORNER OF SECTION 12, NORTHEAST CORNER OF SECTION 13

A. Description of original monument and accessories and/or subsequent restoration:

1825: WM BROOKFIELD, CORNER SET
1973: A. RINGENBERG - 1/2" IRON, CAP AND WITNESSES

B. Description of corner evidence found and/or method applied in restoring or reestablishing corner:

FOUND 1/2" IRON FITTING WITNESS OF RINGENBERG
REMOVED 1/2" IRON AND SET 3/4" x 30" REBAR IRON WITH REMON CAP

C. Description of monument for corner and accessories established to perpetuate locating the position of the corner:

SOUTHEAST CORNER TELEPHONE PEDESTAL	N69°W	6.90'
MAG NAIL IN ROAD INTERSECTION	N30°E	43.91'
P.K. NAIL IN SOUTHEAST SIDE 12" LOCUST	S10°W	19.40'
P.K. NAIL IN SOUTHEAST SIDE OF 12" CRAB APPLE TREE	S60°W	29.07'
P.K. NAIL IN EAST SIDE 3 x 10" TREE	S60°E	18.70'

AND IS ACCEPTED AS THE BEST AVAILABLE EVIDENCE
OF THE POSITION OF THE ORIGINAL CORNER.

Signed by

EDWARD W. REED

Surveyor's Michigan License No. 33985

DATED: AUGUST 17, 2000

	A	B	C	D	E	F	G	H	I	J	K	L	M
1													
2		6		5		4		3		2		1	
3													
4		7		8		9		10		11		12	
5													
6		18		17		16		15		14		13	
7													
8		19		20		21		22		23		24	
9													
10		30		29		28		27		26		25	
11													
12		31		32		33		34		35		36	
13													

