

RECORDED

DEC 14 1993

LAND CORNER RECORDATION CERTIFICATE  
Filing Requirement of Act 74, Mich. P.A. 1970

DEC 2 12 18 PM '93

For corners in COMMISSION

REGISTER OF DEEDS  
INGHAM COUNTY, MICH.

INGHAM (County) Located In: Corner Code ##

1. DELHI TOWNSHIP Public Land Survey T 3N R 2W L-9

2. Property Controlling in Section S T R

3. Miscellaneous Property in Sec. S T R

Register of Deeds Stamp & File Number

4. Lot No. , Recorded Plat

5. Private Claims

I, R.W. Steadman, in a field survey on September 25, 1993 do hereby certify that under requirements of P.A. 74, Michigan P.A. of 1970, the corner points mentioned in lines 1 and 2 above were in conformance with regulations and rules therefore as required in the current manual of survey instructions of the United States Department of the Interior, Bureau of Land Management or by a decree of a Court of Law and/or that the corner points mentioned in lines 3, 4 and 5 above were in conformance with the rules of the Michigan Board of Land Surveyors or by a Decree of a Court of Law; established, re-established, monumented, re-monumented, recovered, found as expressed below:

NOTE: Not more than 4 corners, all in the same town and range, may be recorded on this certificate.

A. Description of original monument and accessories and/or subsequent restoration:

- 1. Original corner set by Musgrove Evans D.S. in Jan 1827  
Elm 18 S7W 16  
Beech 10 N5/E 8

	A	B	C	D	E	F	G	H	I	J	K	L	M
2	5	5	4	3	2	1							
3													
4	7	8	9	10	11	12							
5													
6	18	17	16	15	14	13							
7													
8	19	20	21	22	23	24							
9													
10	30	29	28	27	26	25							
11													
12	31	32	33	34	35	36							
13													

(OVER)

B. Description of corner evidence found and/or method applied in restoring or reestablishing corner:


Searched apparent area of corner and found 1/2" Bar and cap #18998 at N.E. Corner fence post hole with all of R. Lesters witness trees still standing. Excavated all around post and found a few pieces of broken tile among the general run of the mill fence post stones. Accepted bar and cap as corner and replaced with standard Bar and cap.

Field work conducted by Dave Clifford PS#25837

C. Description of monument for corner and accessories established to perpetuate locating the position of the corner:

Standard Ingham County 3/4"x24" Steel Remonumentation Bar and PA 345 Cap #11370 in N.E. Side Old Anchor Post Hole.

- Set Nail & Tag #25837 in E. Side 30" Basswood (Not Maple) Az 326° 14.15'
- Set Nail & Tag #25837 in E. Side 6" Basswood Az 96° 19.00'
- Set Nail & Tag #25837 in S. Side 6" Basswood Az 102° 23.65'
- Set Nail & Tag #25837 in S.E. Side 6" Elm Az 316° 2.20'
- Set Nail & Tag #25837 in W. Side 25" Maple Az 181° 109.31'

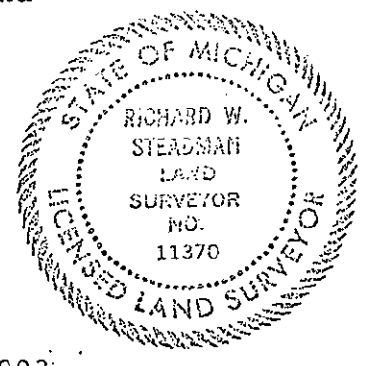

Signed by Richard W. Steadman Date November 23, 1993  
Surveyor's Michigan License No. 11370

2. T.J. Brown Deputy Co. Surveyor used corner in a survey dated April 1851 recorded in Vol. C page 20 with no mention of monument or witnesses.
3. Ronnie Lester LS#18998 recorded corner in Nov. 1977 in Liber 4 of corners page 114 as a  $\frac{1}{2}$ " Bar and cap set at the base of remains of old fence corner post, with fences South and East.

Nail & Tag in East side 36" Maple NNW 14.15'  
Nail & Tag in East side 6" Oak SSE 94.09'  
Nail & Tag in East side 24" Maple South 109.30'