

## LAND CORNER RECORDATION CERTIFICATE

Filing Requirement of Act 74, Mich. P.A. 1970  
WILLIAMSTOWN TOWNSHIP

For corners in

INGHAM

(County)

Located in:

Corner Code ##

1. Public Land Survey

T 4N R 1E

E-12

T R

T R

T R

2. Property Controlling  
in Section

S T R

S T R


3. Miscellaneous  
Property in Sec.

S T R

S T R

4. Lot No. , Recorded Plat

5. Private Claims

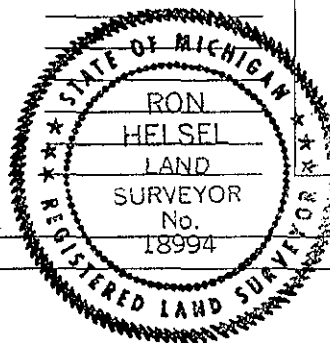

FILED

950006183

12/12/1995 15:10:00

REGISTER OF DEEDS

Paula Johnson

INGHAM COUNTY, MI

Register of Deeds Stamp &amp; File Number

	A	B	C	D	E	F	G	H	I	J	K	L
2	6		5		4		3		2		1	
3												
4	7		8		9		10		11		12	
5												
6	18		17		16		15		14		13	
7												
8	19		20		21		22		23		24	
9												
10	30		29		28		27		26		25	
11												
12	31		32		33		34		35		36	
13												

I, RON HELSEL, in a field survey on OCTOBER 8, 19 95

do hereby certify that under requirements of P.A. 74, Michigan P.A. of 1970, the corner points mentioned in lines 1 and 2 above were in conformance with regulations and rules therefore as required in the current manual of survey instructions of the United States Department of the Interior, Bureau of Land Management or by a decree of a Court of Law and/or that the corner points mentioned in lines 3, 4 and 5 above were in conformance with the rules of the Michigan Board of Land Surveyors or by a Decree of a Court of Law; established, re-established, monumented, re-monumented, recovered, found as expressed below:

**NOTE:** Not more than 4 corners, all in the same town and range, may be recorded on this certificate.

## A. Description of original monument and accessories and/or subsequent restoration:

ORIGINAL MONUMENT: POST SET BY JOSEPH WAMPLER, U.S. DEPUTY SURVEYOR,  
MARCH 1826. BEECH 9, S53W, 18 LINKS  
SUGAR 21, S12E, 21 LINKS

- 1) A L.C.R.C. WAS RECORDED IN LIBER 4, PAGE 90, FIELD DATED MARCH 13, 1976 BY L.J. HENDRYX NO. 3276. HE "FOUND BLUE STONE FOR CORNER AND PROPERTY STAKES EAST." SET GAS PIPE ON TOP IN WEST SHOULDER.  
NW CORNER OF HOUSE, ESE, 114.25' (FOUND)  
CENTER OF 14" MAPLE SE, 83.4' (FOUND TREE)  
CENTER OF POWER POLE, SSW, 101.8' (FOUND POLE)

(CONTINUED ON BACK)

## B. Description of corner evidence found and/or method applied in restoring or reestablishing corner:

FOUND 1/2" REBAR AND CAP #16053 12.2' WEST OF CENTERLINE BURKLEY RD. IN GRAVEL SHOULDER ON LINE WITH FENCE REMNANTS TO EAST. EXCAVATED A 4'X4'X3' DEEP HOLE. FOUND OLD WOOD STAKE NEXT TO 1/2" BAR AT 2.5' DEEP. ACCEPTED POSITION OF 1/2" BAR AS MARKER FOR CORNER. SET 3/4" X 24" FORM PIN AND CAP LABELED P.A. 345, P.S. No. 18994 6" BELOW GRADE IN WEST SHOULDER OF ROAD.

## C. Description of monument for corner and accessories established to perpetuate locating the position of the corner:

3/4" X 24" FORM PIN AND CAP  
FOUND NAIL & TAG #18998 NW/SIDE P. POLE, AZ. 184°, 101.83'  
FOUND NAIL & TAG #18998 SOUTH/SIDE 18" MAPLE, AZ. 146°, 82.95'  
FOUND NAIL & TAG #18998 NE/SIDE P. POLE, AZ. 161°, 109.29'  
SET NAIL & TAG #18994 NORTH/SIDE CEDAR POST EAST, 45.48'  
SET NAIL & TAG #18994 NORTH/SIDE 15" MAPLE, AZ. 110°, 92.80'  
MEASURED E-12 TO E-11 2628.99'  
MEASURED E-12 TO E-13 2648.99'  
MEASURED E-12 TO D-12 2622.70'

Signed by

Date

NOV. 27, 1995

Surveyor's Michigan License No.

18994

P.A. 345 INGHAM COUNTY

PEER APPROVED 12/7/95 ML

FORM APPROVED BY MICHIGAN STATE BOARD OF LAND SURVEYORS, JAN. 28, 19  
REVISED MAY 14, 19  
REVISED JAN., 19

## "A" CONTINUED

- 2) A SURVEY WAS RECORDED IN LIBER 3, PG. 460 BY HENDRYX, DATED 9-23-1977. IDENTIFIED THE CORNER AS GAS PIPE ON TOP OF STONE IN W. SHOULDER OF ROAD. NO WITNESSES.
- 3) A L.C.R.C. WAS RECORDED IN LIBER 5, PG. 281, DATED 4-23, 1979 BY G.M. YOUNG NO. 17640. I BELIEVE THIS DOCUMENT WAS INTENDED TO BE ANOTHER CORNER (POSSIBLY THE EAST 1/4 OF SEC. 33, WILLIAMSTOWN TWP.).
- 4) A SURVEY WAS RECORDED IN LIBER 4, PGS. 215 & 216 BY R.M. LESTER NO. 18998 DATED 9-12-80.  
"FOUND 1/2" PIPE".  
NAIL & TAG IN SOUTH SIDE OF CORNER FENCE POST, EAST, 46.86'  
NW CORNER OF HOUSE #3748, ESE, 114.03' (FOUND)  
NAIL AND TAG IN WEST SIDE OF 14" MAPLE, SE, 83.33' (FOUND)  
NAIL AND TAG IN WEST SIDE OF POWER POLE, SSW, 101.88' (FOUND)
- 5) A SURVEY WAS RECORDED IN LIBER 4, PAGES 666 AND 667, DATED NOV. 1981, BY A.C. WILLIAMS NO. 21275  
GAS PIPE, EAST, 33.0'  
CENTER 14" MAPLE, SE, 83.4'  
CENTER P.P. SSW, 101.8'
- 6) A L.C.R.C. WAS RECORDED IN LIBER 7, PAGE 193, DATED SEPT. 13, 1990 BY J.E. STEPHENS NO. 16053. FOUND BLUE STONE WITH IRON PIPE ON TOP.  
"REPLACED STONE AND PIPE WITH 1/2" DIAMETER STEEL ROD AND CAP LOCATED APPROXIMATELY 2.5 FEET WEST OF WEST EDGE OF PAVEMENT AND APPROXIMATELY 12 INCHES BELOW PAVEMENT." 1/2" DIAMETER STEEL ROD WITNESSED BY TAGS NAILED TO:  
UTILITY POLE, S30°E, 109.20' (FOUND)  
14" MAPLE TREE, S40°E, 82.90' (FOUND)  
UTILITY POLE, S20°W, 101.70' (FOUND)  
NW COR. OF FOUNDATION HOUSE NO. 3748, ESE, 114.25' (FOUND)

LIBRARY COPY UNIT  
DATE 10/10/00  
VOLUME 1000  
PAGE 1000  
1000000  
1000000