

DEC 16 1996

COMMISSION

LAND CORNER RECORDATION CERTIFICATE
Filing Requirement of Act 74, Mich. P.A. 1970
LOCKE TOWNSHIP

Liber

9 Page

59

FILED

960043087
11/08/1996 14:28:52
REGISTER OF DEEDS
Paula Johnson
INGHAM COUNTY, MI


For corners in

INGHAM
(County)

Located In:

Corner Code ##

1. Public Land Survey T 4N R 2E H-12
T R
T R
T R
2. Property Controlling S T R
in Section S T R
3. Miscellaneous S T R
Property in Sec. S T R

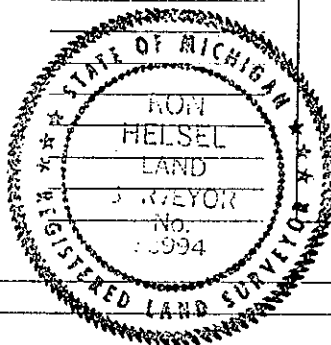

Register of Deeds Stamp & File Number

4. Lot No. , Recorded Plat
5. Private Claims

	A	B	C	D	E	F	G	H	I	J	K	L
2	6		5		4		3		2		1	
3												
4	7		8		9		10		11		12	
5												
6	18		17		16		15		14		13	
7												
8	19		20		21		22		23		24	
9												
10	30		29		28		27		26		25	
11												
12	31		32		33		34		35		36	
13												

I, RON HELSEL, in a field survey on OCTOBER 29, 19 96, do hereby certify that under requirements of P.A. 74, Michigan P.A. of 1970, the corner points mentioned in lines 1 and 2 above were in conformance with regulations and rules therefore as required in the current manual of survey instructions of the United States Department of the Interior, Bureau of Land Management or by a decree of a Court of Law and/or that the corner points mentioned in lines 3, 4 and 5 above were in conformance with the rules of the Michigan Board of Land Surveyors or by a Decree of a Court of Law; established, re-established, monumented, re-monumented, recovered, found as expressed below:

NOTE: Not more than 4 corners, all in the same town and range, may be recorded on this certificate.

- A. Description of original monument and accessories and/or subsequent restoration:
CORNER NOT SET IN ORIGINAL GOVERNMENT SURVEY

- 1) VOL. 2, PG. 182, FEB. 2, 1854. COUNTY SURVEYOR A. JACKSON WITNESSED THIS CORNER AS: BEECH 8" S38 1/2E, 76 1/4 LINKS
W. OAK 15" S32 3/4E, 74 1/2 LINKS
2) A L.C.R.C. WAS RECORDED IN LIBER 6, PAGE 200, FIELD DATED MAY 6, 1981 BY RON LESTER NO. 18998 IN CONJUNCTION WITH THE INGHAM COUNTY CETA PROGRAM. A 10' X 10' X 2.5' DEEP WAS EXCAVATED ON THE NORTH-SOUTH 1/4 LINE FENCES AND THE CENTERLINE OF ROWLEY ROAD. THE CORNER WAS DEEMED LOST AND A CONCRETE MON. WAS SET AT THE INTERSECTION OF THE NORTH-SOUTH AND THE
(CONTINUED ON BACK)

- B. Description of corner evidence found and/or method applied in restoring or reestablishing corner:

FOUND MANGLED REBAR 6" ABOVE PAVEMENT AND BROKEN CONCRETE COLLAR 5' SOUTH CENTERLINE OF ROWLEY ROAD. MEASURED GOOD TO THE (2) REMAINING NAILS AND TAGS FROM 2-A ABOVE. EXCAVATED AND REMOVED BROKEN MON. AND COLLAR. SET 3/4" X 24" FORM PIN AND STEEL MONUMENT BOX FROM THE WITNESSES. ACCEPTED AS FAITHFUL PERPETUATION OF THE CORNER. FENCES ARE NOW GONE.

- C. Description of monument for corner and accessories established to perpetuate locating the position of the corner:
3/4" X 24" FORM PIN IN MON. BOX 5' SOUTH CENTERLINE ROWLEY ROAD. LABELED P.S. NO. 18994, P.A. 345

SET NAIL & TAG NO. 18994 ABOVE NAIL & TAG #18998 W/SIDE 18" MAPLE, AZ. 184°, 21.04'
SET NAIL & TAG NO. 18994 ABOVE NAIL & TAG #18998 N/SIDE 20" WALNUT, AZ. 254°, 67.90'
SET NAIL & TAG NO. 18994 WEST/SIDE TWIN 8" WALNUT IN CLUMP, AZ. 49°, 48.91'
SET NAIL & TAG NO. 18994 NORTH/SIDE 18" ELM, AZ. 110°, 91.69'
SET NAIL & TAG NO. 18994 WEST/SIDE 12" W. PINE, AZ. 197°, 89.08'

Signed by

Ron Helsel

Date

OCT. 30, 1996

Surveyor's Michigan License No.

18994

"A" CONTINUED

EAST-WEST 1/4 LINES OF SECTION 34. CORNER $\pm 5.0'$ SOUTH OF CENTERLINE OF ROWLEY ROAD AND $\pm 2.3'$ EAST OF NORTH-SOUTH FENCE. "MEASURED EAST, 2665.21' TO I-12; MEASURED 2640.96' TO G-12; MEASURED NORTH 2644.23' TO H-11, SOUTH 2626.23' TO H-13. "SET 4" X 36" CONCRETE MONUMENT WITH 1/2" X 38" REROD AND CAP NO. 18998 WITH CONCRETE COLLAR AND COVER."
NAIL & TAG #18998, EAST SIDE FENCE POST, N05°W, 33.34' (GONE)
NAIL & TAG #18998 WEST SIDE 14" MAPLE, SOUTH 21.04' (FOUND)
NAIL & TAG #18998 NORTH SIDE 12" WALNUT, S50°W, 67.90' (FOUND)

RECORDED
INDEXED
FILED
JAN 10 1960
FBI - MEMPHIS