

LAND CORNER RECORDATION CERTIFICATE
Filing Requirement of Act 74, Mich. P.A. 1970

For corners in
Ionia

(County)

Located In:

Corner Code ://

1. Public Land Survey	T	8N	R	7W	C1
	T	8N	R	7W	C3
	T		R		
	T		R		
2. Property Controlling in Section	S		T	R	
	S		T	R	
3. Miscellaneous	S		T	R	
Property in Sec.	S		T	R	

Register of Deeds Stamp & File Number

4. Lot No. _____, Recorded Plat _____
 5. Private Claims _____

C3 April 28, 1992

I, Gary C. Bilow, in a field survey on C1 June 02, 1992, 19_____, do hereby certify that under requirements of P.A. 74, Michigan P.A. of 1970, the corner points mentioned in lines 1 and 2 above were in conformance with regulations and rules therefore as required in the current manual of survey instructions of the United States Department of the Interior, Bureau of Land Management or by a decree of a Court of Law and/or that the corner points mentioned in lines 3, 4 and 5 above were in conformance with the rules of the Michigan Board of Land Surveyors or by a Decree of a Court of Law; established, re-established, monumented, re-monumented, recovered, found as expressed below:

NOTE: Not more than 4 corners, all in the same town and range, may be recorded on this certificate.

	A	B	C	D	E	F	G	H	I	J	K	L	M
2		6	5		4		3		2		1		
3													
4		7	8		9		10		11		12		
5													
6		18	17		16		15		14		13		
7													
8		19	20		21		22		23		24		
9													
10		30	29		28		27		26		25		
11													
12		31	32		33		34		35		36		
13													

A. Description of original monument and accessories and/or subsequent restoration:

C1: Post set by US Deputy Surveyor N. Brookfield in 1837, 42 links (27.72 feet) east of standard corner-accessories Pine 20, S28E, 27 links and Pine 18, S68W, 44 links. In 1891, County surveyor Crawford found an old corner and made new witnesses, a Maple 2, N5E, 21 links and a B Oak 14, S43E, 64 links. Act 74 Certificate by B Wickham, Liber 2, page 289 states he found a capped rerod and witnessed nail in 36" Maple, N5E, 13.67, nail in 36" Oak, S40E, 12.92 and nail in 36" Oak, N80W, 41.82.

C3: Post set by US Deputy Surveyor N. Brookfield in 1837, accessories W Oak 18, N22E, 56links and W Oak 12, S35E, 150 links. County Surveyor Crawford in 1883 found the original corner and witnessed a Pine 10, SE, 90 links and a W Oak 14, S27W, 99-1/2 links. T Chettleburgh in a 1983 Act 74 Certificate in Liber 2, page 133 reports finding a clay tile from Road Commission witnesses and setting an iron bar at the road surface, witnessing 12" Oak, WNW, 96.47; 18" W Pine, NE, 56.64; 24" W Pine, SE, 72.54; 20" Oak, SSK, 203.76.

B. Description of corner evidence found and/or method applied in restoring or reestablishing corner:


C1: Found 1/2" iron bar with cap, RLS 12020 and measured S19E 12.85 to a spike in a 24" Oak and N20E 13.68 to a spike & flasher in a 30" Maple. Standard corner is 27.78 west. Large maple north agrees with 1891 witness. Accepted capped rebar as best evidence of original GLO corner location.

C3: Found 1/2" iron pipe and Chettleburgh's witnesses. Accepted pipe as best evidence of original GLO corner location.

C. Description of monument for corner and accessories established to perpetuate locating the position of the corner:

C1: Left 1/2" capped iron in place
 N85W, 42.25, spike&tag in 34" Oak
 S57W, 45.29, spike&tag in 14" Oak
 West, 3.0, edge of Johnson Road
 S19E, 12.85, spike in 24" Oak
 N20E, 13.68, spike&flasher in 30" Maple

C3: Left 1/2" pipe in place
 West 5.0 centerline Johnson Road
 S32E 72.55 nail&cap in 28" W Pine stump
 N36E 56.64 nail in 18" White Pine
 N66W 77.40 nail&tag in utility pole
 S74W 58.3 stop sign post

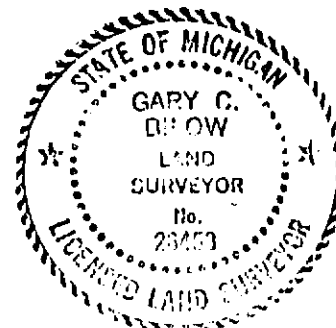

Signed by Gary C. Bilow Date 2/3/92
 Surveyor's Michigan License No. 26453