

SURVEY &
REMONUMENTATION

APR 27 1995

COMMISSION

IOSCO COUNTY REMONUMENTATION CORNER

LAND CORNER RECORDATION CERTIFICATE

Filing Requirement of Act 74, Mich. P.A. 1970

STATE OF MICHIGAN
IOSCO COUNTY
FILED

15 NOV 94 4:01 P.M.

BONITA M. COYLE
REGISTER OF DEEDS

94-07

Register of Deeds Stamp & File Number

For corners in

Iosco
(County)

Located In:

Corner Code ##

- | | | |
|-------------------------|------------|-------|
| 1. Public Land Survey | T 22N R 8E | L - 5 |
| | T R | |
| | T R | |
| | T R | |
| | T R | |
| 2. Property Controlling | S T R | |
| in Section | S T R | |
| 3. Miscellaneous | S T R | |
| Property in Sec. | S T R | |

4. Lot No. , Recorded Plat
5. Private Claims

I, James H. Granger, in a field survey on September, 19 94, do hereby certify that under requirements of P.A. 74, Michigan P.A. of 1970, the corner points mentioned in lines 1 and 2 above were in conformance with regulations and rules therefore as required in the current manual of survey instructions of the United States Department of the Interior, Bureau of Land Management or by a decree of a Court of Law and/or that the corner points mentioned in lines 3, 4 and 5 above were in conformance with the rules of the Michigan Board of Land Surveyors or by a Decree of a Court of Law; established, re-established, monumented, re-monumented, recovered, found as expressed below:

NOTE: Not more than 4 corners, all in the same town and range, may be recorded on this certificate.

A. Description of original monument and accessories and/or subsequent restoration:

1843 Original Survey
John Mullett

Set Wood Post
No witnesses

1979 Survey

Mon at corner location

B. Description of corner evidence found and/or method applied in restoring or reestablishing corner:

Found 3/4" Pipe as previously recorded. Accepted position as established.


ACCEPTED BY THE IOSCO COUNTY
SURVEY PEER GROUP AS THE
OFFICIAL CORNER UNDER P.A.
345 OF 1990 AT A MEETING
HELD ON 10-10-94

James H. Granger

C. Description of monument for corner and accessories established to perpetuate locating the position of the corner:

Set 5/8" rebar with alum. cap

20" White Pine N85°E 32.22' Set Nail & Tag
Power Pole N50°E 92.40' Set Nail & Tag
10" Cedar S50°W 17.87' Set Nail & Tag
Power Pole N55°W 157.27' Set Nail & Tag

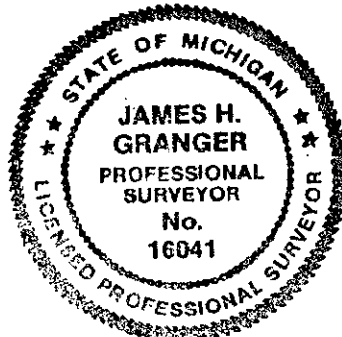

Signed by *James H. Granger*

Date November 10, 1994

Surveyor's Michigan License No. 16041