

SURVEY &
REMONUMENTATION

APR 27 1995

COMMISSION

IOSCO COUNTY REMONUMENTATION CORNER
LAND CORNER RECORDATION CERTIFICATE

Filing Requirement of Act 74, Mich. P.A. 1970

STATE OF MICHIGAN
IOSCO COUNTY
FILED

5 DEC 94 1:54 P.M.

BONITA M. COYLE
REGISTER OF DEEDS

94-22

Register of Deeds Stamp & File Number

For corners in

Iosco

(County)

Located In:

Corner Code ##

1. Public Land Survey

T R

T R

T R

T R

2. Property Controlling
in Section

S 21 T 22N R 8E

S T R

3. Miscellaneous

S T R

Property in Sec.

S T R

No. 1
E-8 to E-9

4. Lot No. , Recorded Plat

5. Private Claims

I, James H. Granger, in a field survey on September, 19 94,
do hereby certify that under requirements of P.A. 74, Michigan P.A. of 1970, the corner points mentioned
in lines 1 and 2 above were in conformance with regulations and rules therefore as required in the
current manual of survey instructions of the United States Department of the Interior, Bureau of Land
Management or by a decree of a Court of Law and/or that the corner points mentioned in lines 3, 4 and 5
above were in conformance with the rules of the Michigan Board of Land Surveyors or by a Decree of a
Court of Law; established, re-established, monumented, re-monumented, recovered, found as
expressed below:

NOTE: Not more than 4 corners, all in the same town and range, may be recorded
on this certificate.

A. Description of original monument and accessories and/or subsequent restoration:

1843 Original Survey
John Mullett

Set Wood Post
8" B. Oak
S78°W 20 lks
8" B. Oak
S39°E 10 lks

1888 Sub'd
1932 MDOT
1940 Sub'd

Emery Bros. Add'n to
Village of East Tawas
2" gas pipe
Mertz Add'n to East
Tawas

1880 Sub'd


Trustee's Add'n to Village
of East Tawas

B. Description of corner evidence found and/or method applied in restoring or reestablishing corner:

Field search located cor. E-8 and ex. monuments of sub'd to establish sec. line.
Extended sec. line and using record distances cor. position falls 50' into Lake
Huron. Set witness corner 84.29' N. of cor. position on sec. line.

ACCEPTED BY THE IOSCO COUNTY
SURVEY PEER GROUP AS THE
OFFICIAL CORNER UNDER P.A.
345 OF 1990 AT A MEETING
HELD ON 11-10-94

James H. Granger

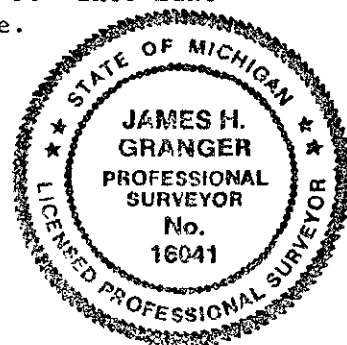

C. Description of monument for corner and accessories established to perpetuate locating the position of the corner:

Set 5/8" x 30" rebar with alum. cap as witness cor. to section cor.

S45°E 29.02' Set tag in 4' Willow Cluster
N65°E 71.86' Set tag in 8" Ash
N15°W 95.54' S.W. cor. Little Cesar Pizza (Yellow Block Building)
S85°W 83.80' Set tag in 3.5' Willow Cluster

Signed by James H. Granger

Date November 10, 1994

Surveyor's Michigan License No. 16041