

SURVEY & REMONUMENTATION

MAY 07 1997

COMMISSION

1996 IOSCO COUNTY REMONUMENTATION

LAND CORNER RECORDATION CERTIFICATE

Filing Requirement of Act 74, Mich. P.A. 1970

96-53

For corners in

<u>Iosco</u> (County)	Located In:	Corner Code =#
1. Public Land Survey	T <u>22N</u> R <u>8E</u>	<u>E-6 to E-5</u> #9
	T _____ R _____	_____
	T _____ R _____	_____
	T _____ R _____	_____
2. Property Controlling	S _____ T _____ R _____	_____
in Section	S _____ T _____ R _____	_____
3. Miscellaneous	S _____ T _____ R _____	_____
Property in Sec.	S _____ T _____ R _____	_____

STATE OF MICHIGAN
IOSCO COUNTY
FILED

5 NOV 96 4:30 P.M.

BONITA H. COYLE
REGISTER OF DEEDS

Register of Deeds Stamp & File Number

4. Lot No. _____, Recorded Plat _____

5. Private Claims _____

I, James H. Granger, in a field survey on October 25, 19 96, do hereby certify that under requirements of P.A. 74, Michigan P.A. of 1970, the corner points mentioned in lines 1 and 2 above were in conformance with regulations and rules therefore as required in the current manual of survey instructions of the United States Department of the Interior, Bureau of Land Management or by a decree of a Court of Law and/or that the corner points mentioned in lines 3, 4 and 5 above were in conformance with the rules of the Michigan Board of Land Surveyors or by a Decree of a Court of Law; established, re-established, monumented, re-monumented, recovered, found as expressed below:

NOTE: Not more than 4 corners, all in the same town and range, may be recorded on this certificate.

A. Description of original monument and accessories and/or subsequent restoration:

1843	GLO	John Mullett	Set Wood Post		
			8" Beech	S 66° E	33 lks
			6" Beech	S 1½° W	4 lks

1921 Sub'd John Applin #318 Indicates M.C. position

B. Description of corner evidence found and/or method applied in restoring or reestablishing corner:


No evidence of previously established corner could be found. Reestablished corner position on extension of W. Sec. line from SW cor. thru W¼ Cor. North along with measurement from subdivision.

ACCEPTED BY THE IOSCO COUNTY
SURVEY PEER GROUP AS THE
OFFICIAL CORNER UNDER P.A.
345 OF 1990 AT A MEETING
HELD ON 10-23-96

James H. Granger

C. Description of monument for corner and accessories established to perpetuate locating the position of the corner:

5/8"x30" rebar w/Remon. Cap			
14" Willow	N 75° E	3.86'	nail & tag
12" Ash	S 35° E	6.10'	nail & tag
14" Ash	S 5° E	22.25'	nail & tag
14" Willow	S 25° W	21.60'	nail & tag

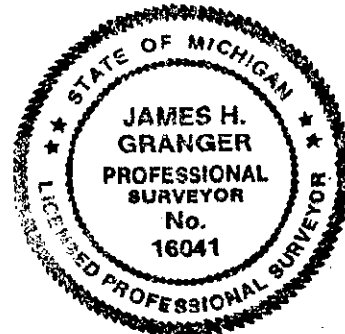

Signed by *James H. Granger*

Date October 28, 1996

Surveyor's Michigan License No. 16041