

# SURVEY & REMONUMENTATION

MAY 07 1997

COMMISSION

## 1996 IOSCO COUNTY REMONUMENTATION LAND CORNER RECORDATION CERTIFICATE Filing Requirement of Act 74, Mich. P.A. 1970

96-55

For corners in

Iosco (County)	Located In:	Corner Code #
1. Public Land Survey	T 22N R 8E	F-9 to G-9 #10
	T R	
	T R	
	T R	
2. Property Controlling in Section	S T R	
	S T R	
3. Miscellaneous Property in Sec.	S T R	
	S T R	

STATE OF MICHIGAN  
IOSCO COUNTY  
FILED

5 NOV 96 4:31 P.M.

MONITA M. COYLE  
REGISTER OF DEEDS

Register of Deeds Stamp & File Number

4. Lot No. \_\_\_\_\_, Recorded Plat \_\_\_\_\_  
5. Private Claims \_\_\_\_\_

	A	B	C	D	E	F	G	H	I	J	K	L	M
2	6		5		4		3		2		1		
3													
4	7		8		9		10		11		12		
5													
6	18		17		16		15		14		13		
7													
8	19		20		21		22		23		24		
9													
10	30		29		28		27		26		25		
11													
12	31		32		33		34		35		36		
13													

I, James H. Granger, in a field survey on October 25, 19 96, do hereby certify that under requirements of P.A. 74, Michigan P.A. of 1970, the corner points mentioned in lines 1 and 2 above were in conformance with regulations and rules therefore as required in the current manual of survey instructions of the United States Department of the Interior, Bureau of Land Management or by a decree of a Court of Law and/or that the corner points mentioned in lines 3, 4 and 5 above were in conformance with the rules of the Michigan Board of Land Surveyors or by a Decree of a Court of Law; established, re-established, monumented, re-monumented, recovered, found as expressed below:

**NOTE: Not more than 4 corners, all in the same town and range, may be recorded on this certificate.**

A. Description of original monument and accessories and/or subsequent restoration:  
1843 GLO John Mullett Corner was 12" Cottonwood  
1990 LCRC John Oliver #19840 Claims to have set M.C. by extension of N-S 1/4 line. This does not agree with GLO notes and is considered to be a bogus corner.


B. Description of corner evidence found and/or method applied in restoring or reestablishing corner:  
No original evidence found. Reestablished position by single proportionate distance on a straight line between SW and SE Sec. corners.

ACCEPTED BY THE IOSCO COUNTY  
SURVEY PEER GROUP AS THE  
OFFICIAL CORNER UNDER P.A.  
345 OF 1990 AT A MEETING  
HELD ON 10-23-96

*James H. Granger*

C. Description of monument for corner and accessories established to perpetuate locating the position of the corner:

5/8" x 30" rebar w/Remon. Cap			
10" Oak	North	39.00'	nail & tag
8" Oak	N 20° W	46.20'	nail & tag
10" Twin Oak	N 45° W	27.65'	nail & tag
S.W. Cor. Yellow house	N 30° E	86.05'	nail & tag

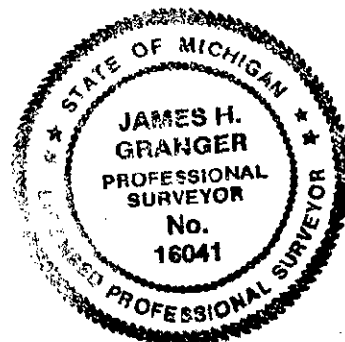

Signed by James H. Granger Date October 28, 1996

Surveyor's Michigan License No. 16041