

SURVEY &
REMONUMENTATION

APR 27 1995

COMMISSION

IOSCO COUNTY REMONUMENTATION CORNER

LAND CORNER RECORDATION CERTIFICATE

Filing Requirement of Act 74, Mich. P.A. 1970

STATE OF MICHIGAN
IOSCO COUNTY
FILED

5 DEC 94 2:01 P.M.

BONITA M. COYLE
REGISTER OF DEEDS

94-40

Register of Deeds Stamp & File Number

For corners in

IOSCO

(County)

Located In:

Corner Code ##

1. Public Land Survey

T 22N R 9E G-1 to G-2

T R

T R

T R

T R

2. Property Controlling
in Section

S T R

S T R

3. Miscellaneous

S T R

Property in Sec.

S T R

4. Lot No. , Recorded Plat

5. Private Claims

I, John F. Oliver in a field survey on September 12, 1994, do hereby certify that under requirements of P.A. 74, Michigan P.A. of 1970, the corner points mentioned in lines 1 and 2 above were in conformance with regulations and rules therefore as required in the current manual of survey instructions of the United States Department of the Interior, Bureau of Land Management or by a decree of a Court of Law and/or that the corner points mentioned in lines 3, 4 and 5 above were in conformance with the rules of the Michigan Board of Land Surveyors or by a Decree of a Court of Law; established, re-established, monumented, re-monumented, recovered, found as expressed below:

NOTE: Not more than 4 corners, all in the same town and range, may be recorded on this certificate.

A. Description of original monument and accessories and/or subsequent restoration:

1843 Original Survey, J.F.Munro, Set wood post, No trees, No witnesses

1954 Subdivision (AuSable Point Beach No.5) L.7, p. 2 & 3, indicates Concrete Monument at SW corner of Lot 17, by R.J. Cooke

B. Description of corner evidence found and/or method applied in restoring or reestablishing corner:

1994 accept position as established by subdivision, found square concrete monument.


C. Description of monument for corner and accessories established to perpetuate locating the position of the corner:

Square Concrete monument, with aluminum cap

6" Jackpine N50°E 5.98
SW corner of garage N12°e 112.10
5" Jackpine N02°W 12.63
4" Jackpine S13°W 17.55
3" Jackpine N74°W 74.12

ACCEPTED BY THE IOSCO COUNTY
SURVEY PEER GROUP AS THE
OFFICIAL CORNER UNDER P.A.
345 OF 1990 AT A MEETING
HELD ON 11-10-94

James H. Drayner

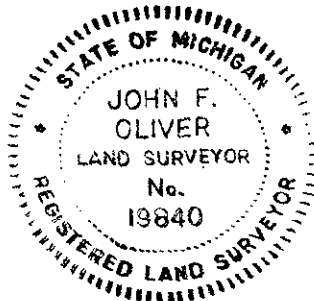

Signed by [Signature]
Surveyor's Michigan License No. 19840

Date 11-11-94