

SURVEY &  
REMONUMENTATION

APR 27 1995

COMMISSION

REMONUMENTATION CORNER  
LAND CORNER RECORDATION CERTIFICATE  
Filing Requirement of Act 74, Mich. P.A. 1970

STATE OF MICHIGAN  
IOSCO COUNTY  
FILED

5 DEC 94 2:03 P.M.

BONITA H. COYLE  
REGISTER OF DEEDS

94-50

Register of Deeds Stamp & File Number

For corners in

IOSCO  
(County)

Located In:

Corner Code #

1. Public Land Survey

T 22N R 9E

G-1 to H-1

2. Property Controlling  
in Section

S T R

3. Miscellaneous  
Property in Sec.

S T R

No. 3

4. Lot No. , Recorded Plat

5. Private Claims

I, John F. Oliver, in a field survey on September 12, 19 94,  
do hereby certify that under requirements of P.A. 74, Michigan P.A. of 1970, the corner points mentioned  
in lines 1 and 2 above were in conformance with regulations and rules therefore as required in the  
current manual of survey instructions of the United States Department of the Interior, Bureau of Land  
Management or by a decree of a Court of Law and/or that the corner points mentioned in lines 3, 4 and 5  
above were in conformance with the rules of the Michigan Board of Land Surveyors or by a Decree of a  
Court of Law; established, re-established, monumented, re-monumented, recovered, found as  
expressed below:

NOTE: Not more than 4 corners, all in the same town and range, may be recorded  
on this certificate.

A. Description of original monument and accessories and/or subsequent restoration:

1843 Original Survey by J.F. Munro set wood post no trees no witnesses

1944 Subdivision, AuSable Point Beach No.2 (L.4, P.32-35) indicates concrete  
monument at SE corner of Lot 34, by R.J. Cooke

B. Description of corner evidence found and/or method applied in restoring or reestablishing corner:

1994 Accept position as established by subdivision, corner falls in  
eroded area set on plat line on firm ground. Set 5/8"X 30" re-bar and  
Aluminum cap


ACCEPTED BY THE IOSCO COUNTY  
SURVEY PEER GROUP AS THE  
OFFICIAL CORNER UNDER P.A.  
345 OF 1990 AT A MEETING  
HELD ON 11-10-94

*James H. Granger*

C. Description of monument for corner and accessories established to perpetuate locating the position of the corner:

5/8"X 30" re-bar with aluminum cap

NE corner House S36°W 38.97  
Concrete Monument N85°W 86.81  
NW corner House S71°W 58.00  
SW Corner House N30°W 51.15

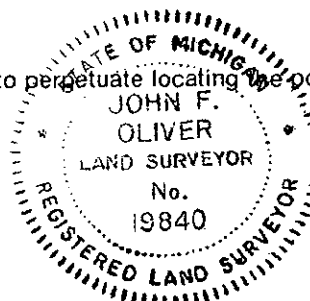

Corner is located between House #1980 and House #1976, AuSable Point Road

Signed by *[Signature]*

Date

11-11-94

Surveyor's Michigan License No. 19840