

173 2 2 1995

95-25

IOSCO COUNTY REMONUMENTATION  
LAND CORNER RECORDATION CERTIFICATE  
Filing Requirement of Act 74, Mich. P.A. 1970

STATE OF MICHIGAN  
IOSCO COUNTY  
FILED

12 DEC 95 2:28 P.M.

BONITA M. COYLE  
REGISTER OF DEEDS

For corners in

IOSCO  
(County)

Located In:

Corner Code #

1. Public Land Survey

T 22 N 9 E

C-3 TO D-3 04

T R

T R

T R

T R

2. Property Controlling  
in Section

S T R

S T R

3. Miscellaneous  
Property in Sec.

S T R

S T R

No. 4

Register of Deeds Stamp & File Number

4. Lot No. , Recorded Plat

5. Private Claims

I, WILLIAM E. WOODS in a field survey on 10-2-1995 do hereby state that under requirements of P.A. 74, Michigan P.A. of 1970, the corner points mentioned in lines 1 and 2 above were in conformance with regulations and rules therefore as required in the current manual of survey instructions of the United States Department of the Interior, Bureau of Land Management or by a decree of a Court of Law and/or that the corner points mentioned in lines 3, 4 and 5 above were in conformance with the rules of the Michigan Board of Land Surveyors or by a Decree of a Court of Law; established, re-established, monumented, recovered, found as expressed below:

NOTE: Not more than 2 corners, all in the same town and range, may be recorded on this certificate.

	A	B	C	D	E	F	G	H	I	J	K	L	M
1													
2		6		5		4		3		2		1	
3													
4		7		8		9		10		11		12	
5													
6		18		17		16		15		14		13	
7													
8		19		20		21		22		23		24	
9													
10		30		29		28		27		26		25	
11													
12		31		32		33		34		35		36	
13													

A. Description of original monument and accessories and/or subsequent restoration:

1843 ORIGINAL SURVEY, J. F. MUNRO

SET WOOD POST

8" S. PINE N 11°W

14 LKS

8" S. PINE S 42°W

69 LKS

B. Description of corner evidence found and/or method applied in restoring or reestablishing corner:

1922 SUBDIVISION, JOHN W. APPLIN

HURON SHORE SUBDIVISION L. 2 P. 1

SE COR. LOT 1 IS INDICATED AS CORNER

ACCEPTED BY THE IOSCO COUNTY  
SURVEY PEER GROUP AS THE  
OFFICIAL CORNER UNDER P.A.  
345 OF 1990 AT A MEETING  
HELD ON 10-31-95

James H. Granger

C. Description of monument for corner and accessories established to perpetuate locating the position of the corner:

1995 REMONUMENTATION, WILLIAM E. WOODS #25882

ACCEPT POSITION AS ESTABLISHED BY SUB'N.

SET 5/8" BAR WITH ALUMINUM CAP

9" W. PINE S 5°W 19.67


20" R. PINE N62°E 31.72

P.P N35°E 40.89

8" MAPLE N48°W 49.32

CORNER IS 11.5 FT. E. EAST EDGE

ASPHALT OF MEDIA DRIVE

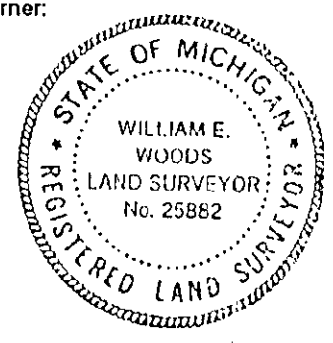

Signed by William E Woods

Date 12-8-95

Surveyor's Michigan License No. 25882