

SURVEY &  
REMONUMENTATION

MAY 07 1997

COMMISSION

IOSCO COUNTY REMONUMENTATION  
LAND CORNER RECORDATION CERTIFICATE  
Filing Requirement of Act 74, Mich. P.A. 1970

96-70

For corners in

IOSCO

(County)

Located In:

Corner Code #

NO. 6

G-1 to G-2

1. Public Land Survey

T\_\_\_ R\_\_\_  
T\_\_\_ R\_\_\_  
T\_\_\_ R\_\_\_  
T\_\_\_ R\_\_\_

2. Property Controlling  
in Section

S\_\_\_ T\_\_\_ R\_\_\_  
S\_\_\_ T\_\_\_ R\_\_\_

3. Miscellaneous  
Property in Sec.

S\_\_\_ T\_\_\_ R\_\_\_  
S\_\_\_ T\_\_\_ R\_\_\_

4. Lot No. \_\_\_\_\_, Recorded Plat \_\_\_\_\_

5. Private Claims \_\_\_\_\_

STATE OF MICHIGAN  
IOSCO COUNTY  
FILED

6 DEC 96 2:11 P.M.

BONITA M. COYLE  
REGISTER OF DEEDS

Register of Deeds Stamp & File Number

I, WILLIAM E. WOODS in a field survey on NOV. 19, 1996 do hereby state that under requirements of P.A. 74, Michigan P.A. of 1970, the corner points mentioned in lines 1 and 2 above were in conformance with regulations and rules therefore as required in the current manual of survey instructions of the United States Department of the Interior, Bureau of Land Management or by a decree of a Court of Law and/or that the corner points mentioned in lines 3, 4 and 5 above were in conformance with the rules of the Michigan Board of Land Surveyors or by a Decree of a Court of Law; established, re-established, monumented, recovered, found as expressed below:

NOTE: Not more than 2 corners, all in the same town and range, may be recorded on this certificate.

	A	B	C	D	E	F	G	H	I	J	K	L	M
1													
2		6		5		4		3		2		1	
3													
4		7		8		9		10		11		12	
5													
6		18		17		16		15		14		13	
7													
8		19		20		21		22		23		24	
9													
10		30		29		28		27		26		25	
11													
12		31		32		33		34		35		36	
13													

A. Description of original monument and accessories and/or subsequent restoration:

1843: ORIGINAL GOVERNMENT SURVEY

SET POST 77.18 TO RIVER SAUBLE. SET  
POST RIGHT BANK. 20" W. PINE S66°E,  
33 LINKS, 16" W. PINE S19°W, 37 LINKS.

B. Description of corner evidence found and/or method applied in restoring or reestablishing corner:

1996: WILLIAM E. WOODS


SET MEANDER CORNER AT 4995.29 NORTH OF  
G-3.

ACCEPTED BY THE IOSCO COUNTY  
SURVEY PEER GROUP AS THE  
OFFICIAL CORNER UNDER P.A.  
345 OF 1990 AT A MEETING  
HELD ON 10-23-96

*James H. Granger*

C. Description of monument for corner and accessories established to perpetuate locating the position of the corner:

5/8 BAR WITH ALUMINUM CAP  
8" J. PINE S59°E 12.08  
TWIN 6" J. PINE S20°E 10.78  
TWIN 6" J. PINE N77°W 9.79  
8" J. PINE N32°W 6.75

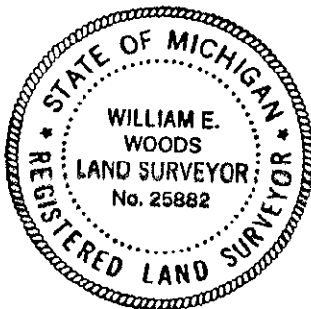

Signed by William E Woods

Date NOVEMBER 19, 1996

Surveyor's Michigan License No. 25882