

# SURVEY & REMONUMENTATION

MAY 07 1997

## COMMISSION

### IOSCO COUNTY REMONUMENTATION LAND CORNER RECORDATION CERTIFICATE Filing Requirement of Act 74, Mich. P.A. 1970

96-73

For corners in

IOSCO

(County)

Located In:

Corner Code #

NO. 9

1. Public Land Survey

T 23N R 9E

G-1 to G-2

T R

T R

T R

T R

2. Property Controlling  
in Section

S

T R

S

T R

3. Miscellaneous  
Property in Sec.

S

T R

S

T R

STATE OF MICHIGAN  
IOSCO COUNTY  
FILED

6 DEC 96 2:11 P.M.

BONITA M. COYLE  
REGISTER OF DEEDS

Register of Deeds Stamp & File Number

4. Lot No. , Recorded Plat

5. Private Claims

I, WILLIAM E. WOODS in a field survey on NOV. 19, 1996 do hereby state that under requirements of P.A. 74, Michigan P.A. of 1970, the corner points mentioned in lines 1 and 2 above were in conformance with regulations and rules therefore as required in the current manual of survey instructions of the United States Department of the Interior, Bureau of Land Management or by a decree of a Court of Law and /or that the corner points mentioned in lines 3, 4 and 5 above were in conformance with the rules of the Michigan Board of Land Surveyors or by a Decree of a Court of Law; established, re-established, monumented, recovered, found as expressed below:

NOTE: Not more than 2 corners, all in the same town and range, may be recorded on this certificate.

	A	B	C	D	E	F	G	H	I	J	K	L	M
1													
2	6			5			4		3		2		1
3													
4	7			8			9		10		11		12
5													
6	18			17			16		15		14		13
7													
8	19			20			21		22		23		24
9													
10	30			29			28		27		26		25
11													
12	31			32			33		34		35		36
13													

A. Description of original monument and accessories and/or subsequent restoration:

1843: ORIGINAL GOVERNMENT SURVEY

SET POST 52.31 OVER SABLE RIVER. SET POST ON LEFT BANK 12" WILLOW N32°W, 15 LINKS.

B. Description of corner evidence found and/or method applied in restoring or reestablishing corner:

1996: WILLIAM E. WOODS

SET 5/8 ROD 7.0' NORTH OF SAUSABLE RIVER. SET MEANDER CORNER AT 3547.62 NORTH OF G-3.

ACCEPTED BY THE IOSCO COUNTY  
SURVEY PEER GROUP AS THE  
OFFICIAL CORNER UNDER P.A.  
345 OF 1990 AT A MEETING  
HELD ON 10-23-96

*James H. Granger*

C. Description of monument for corner and accessories established to perpetuate locating the position of the corner:


5/8 ROD WITH ALUMINUM CAP

8" ASH N01°W 19.26

6" ASH N78°E 11.72

6" ASH S67°E 14.69

TWIN 8" ASH S45°E 11.75

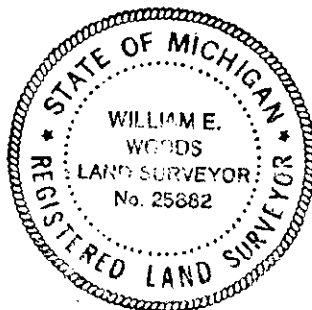

Signed by *William E. Woods*

Date NOVEMBER 19, 1996

Surveyor's Michigan License No. 25882