

MAY 07 1997

COMMISSION

IOSCO COUNTY REMONUMENTATION  
LAND CORNER RECORDATION CERTIFICATE  
Filing Requirement of Act 74, Mich. P.A. 1970

96-74

For corners in

IOSCO  
(County)

Located In:

Corner Code #

NO. 10

1. Public Land Survey

T23NR9E

G-1 to G-2

T R  
T R  
T R

2. Property Controlling  
in Section

S T R  
S T R

3. Miscellaneous  
Property in Sec.

S T R  
S T R

STATE OF MICHIGAN  
IOSCO COUNTY  
FILED

6 DEC 96 2:11 P.M.

RONITA M. COYLE  
REGISTER OF DEEDS

Register of Deeds Stamp & File Number

4. Lot No. , Recorded Plat  
5. Private Claims

I, WILLIAM E. WOODS, in a field survey on NOV. 19 19 96 do hereby state that under requirements of P.A. 74, Michigan P.A. of 1970, the corner points mentioned in lines 1 and 2 above were in conformance with regulations and rules therefore as required in the current manual of survey instructions of the United States Department of the Interior, Bureau of Land Management or by a decree of a Court of Law and /or that the corner points mentioned in lines 3, 4 and 5 above were in conformance with the rules of the Michigan Board of Land Surveyors or by a Decree of a Court of Law; established, re-established, monumented, recovered, found as expressed below:

NOTE: Not more than 2 corners, all in the same town and range, may be recorded on this certificate.

	A	B	C	D	E	F	G	H	I	J	K	L	M
1													
2	6			5			4		3		2		1
3													
4	7			8			9		10		11		12
5													
6	18			17			16		15		14		13
7													
8	19			20			21		22		23		24
9													
10	30			29			28		27		26		25
11													
12	31			32			33		34		35		36
13													

A. Description of original monument and accessories and/or subsequent restoration:

1843: ORIGINAL GOVERNMENT NOTES

49.47 LINKS TO RIVER. SAUBLE SET POST ON RIGHT BANK. AN ELM 10" DIAM. S47°W, 13 LINKS.

B. Description of corner evidence found and/or method applied in restoring or reestablishing corner:

1996: WILLIAM E. WOODS


SET 5/8 ROD 6.0' SOUTH OF RIVER 5.5' FROM EDGE OF PAVEMENT ON MILL STREET. SET MEANDER CORNER 3052.31 NORTH OF G-3.

ACCEPTED BY THE IOSCO COUNTY  
SURVEY PEER GROUP AS THE  
OFFICIAL CORNER UNDER P.A.  
345 OF 1920 AT A MEETING  
HELD ON 10-23-96

James H. Shanger

C. Description of monument for corner and accessories established to perpetuate locating the position of the corner:

5/8 ROD WITH ALUMINUM CAP  
6x8 GUARD RAIL POST DUE SOUTH 1.74  
6x8 GUARD RAIL POST N51°W 12.19  
6x8 GUARD RAIL POST S33°E 13.24  
P.P. S23°W 57.37

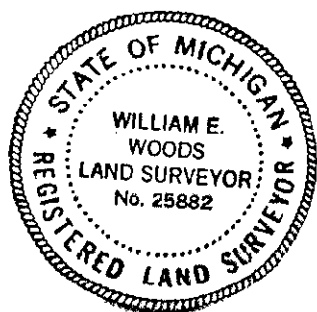

Signed by William E. Woods

Date NOVEMBER 19, 1996

Surveyor's Michigan License No. 25882