

MAY 07 1987

COMMISSION

IOSCO COUNTY REMONUMENTATION
LAND CORNER RECORDATION CERTIFICATE
Filing Requirement of Act 74, Mich. P.A. 1970

96-68

STATE OF MICHIGAN
IOSCO COUNTY
FILED

For corners in

IOSCO

(County)

Located In:

Corner Code #

NO. 11

G-2 to G-3

1. Public Land Survey

T23N R9E

T R

T R

T R

2. Property Controlling
in Section

S

T R

S

T R

3. Miscellaneous
Property in Sec.

S

T R

S

T R

6 DEC 96 2:10 P.M.

RONITA M. COYLE
REGISTER OF DEEDS

Register of Deeds Stamp & File Number

4. Lot No. _____, Recorded Plat _____
5. Private Claims _____

I, WILLIAM E. WOODS in a field survey on NOV. 19, 1996 do hereby state that under requirements of P.A. 74, Michigan P.A. of 1970, the corner points mentioned in lines 1 and 2 above were in conformance with regulations and rules therefore as required in the current manual of survey instructions of the United States Department of the Interior, Bureau of Land Management or by a decree of a Court of Law and for that the corner points mentioned in lines 3, 4 and 5 above were in conformance with the rules of the Michigan Board of Land Surveyors or by a Decree of a Court of Law; established, re-established, monumented, recovered, found as expressed below:

NOTE: Not more than 2 corners, all in the same town and range, may be recorded on this certificate.

	A	B	C	D	E	F	G	H	I	J	K	L	M
1													
2	6			5		4		3		2		1	
3													
4	7			8		9		10		11		12	
5													
6	18			17		16		15		14		13	
7													
8	19			20		21		22		23		24	
9													
10	30			29		28		27		26		25	
11													
12	31			32		33		34		35		36	
13													

A. Description of original monument and accessories and/or subsequent restoration:

1843: ORIGINAL GOVERNMENT NOTES

34.97 LINKS INTERSECT N. LINE OF
PRIVATE CLAIM. SET POST IN MARSH
NO TREES. MEASURED ON SAID N. LINE
26.88 CHAINS TO COVE ON BAYOU &
EXTEND SAID LINE 3.12 TO RIVER. SAUBLE
SET IN MARSH, NO TREES.
AU SABLE HEIGHTS SAYS PART OF CHEVALLIERS
CLAIM, BUT DOES NOT SHOW CLAIM BOUNDARY.

1945: R.J. COOKE

B. Description of corner evidence found and/or method applied in restoring or reestablishing corner:


1996: WILLIAM E. WOODS

NORTH LINE OF CLAIM WAS ESTABLISHED
BY USING PLATTED LOCATION ON SOUTH
LINE OF CLAIM AND THEN GOING THE
SECTION LINE WIDTH 1815.59 NORTH
OF G-2. NORTH LINE OF CLAIM IS 2331.44 NORTH OF G-2 IN POND. SET WITNESS
CORNER AT 2380.09 NORTH OF G-2.

CORNER
IS IN POND. SET WITNESS CORNER ON
SECTION LINE 48.65' N OF THE N LINE
OF CLAIM.

C. Description of monument for corner and accessories established to perpetuate locating the position of the corner:

SET 5/8 ROD 48.65 FEET NORTH OF NORTH CLAIM LINE, 10.0 FEET SOUTH TO WATER.
8" BEECH S58°E 27.41
8" ASH S17°E 9.33
6" ASH N83°W 7.52
TRIPLE 12" POPLAR N30°E 55.50

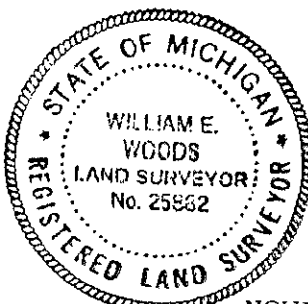

ACCEPTED BY THE IOSCO COUNTY
SURVEY PEER GROUP AS THE
OFFICIAL CORNER UNDER P.A.
345 OF 1990 AT A MEETING
HELD ON 10-23-96
James H. Chandler

Signed by William E. Woods

Date NOVEMBER 19, 1996

Surveyor's Michigan License No. 25882