

SURVEY & REMONUMENTATION

MAY 07 1997

COMMISSION

IOSCO COUNTY REMONUMENTATION LAND CORNER RECORDATION CERTIFICATE Filing Requirement of Act 74, Mich. P.A. 1970

96-67

For corners in

IOSCO

(County)

Located In:

Corner Code #

NO. 12

G-2 to G-3

1. Public Land Survey

T23NR9E

T R

T R

T R

S T R

S T R

S T R

S T R

2. Property Controlling in Section

3. Miscellaneous Property in Sec.

4. Lot No. , Recorded Plat

5. Private Claims

I, WILLIAM E. WOODS in a field survey on NOV. 19, 1996 do hereby state that under requirements of P.A. 74, Michigan P.A. of 1970, the corner points mentioned in lines 1 and 2 above were in conformance with regulations and rules therefore as required in the current manual of survey instructions of the United States Department of the Interior, Bureau of Land Management or by a decree of a Court of Law and /or that the corner points mentioned in lines 3, 4 and 5 above were in conformance with the rules of the Michigan Board of Land Surveyors or by a Decree of a Court of Law; established, re-established, monumented, recovered, found as expressed below:

NOTE: Not more than 2 corners, all in the same town and range, may be recorded on this certificate.

A. Description of original monument and accessories and/or subsequent restoration:

1843: ORIGINAL GOVERNMENT SURVEY

1866: J.M. JOHNSTON

1945: R.J. COOKE

SET POST 7.50 N. OF S.W. SECTION CORNER 16" Y. PINE S52°E, 44 LINKS, 14" Y. PINE, S31°W, 77 LINKS, MEASURED S85°E, ON SAID SOUTH LINE OF P.C. 37.70 CHAINS TO RIVER.

MAP OF PIERCE SUB. N. PLAT BOUNDARY IS S. LINE CHEVALIER CLAIM. AUSABLE HEIGHTS SAYS PART OF CHEVELLIERS CLAIM, BUT DOES NOT SHOW CLAIM BOUNDARY.

B. Description of corner evidence found and/or method applied in restoring or reestablishing corner:

(CONTINUES FROM A): 1965: J.C. MILLER

SUP. PLAT OF CHEVALIER HEIGHTS SHOWS SOUTH LINE OF CHEVALIERS CLAIM.

1996: WILLIAM E. WOODS

INTERSECTED SOUTH CLAIM LINE AND SECTION LINE AND SECTION LINE AT 515.85' MEASURED 495' GOVERNMENT RECORDED NORTH OF G-3.

C. Description of monument for corner and accessories established to perpetuate locating the position of the corner:


SET 5/8 ROD WITH ALUMINUM CAP

10" POPLAR S84°E 46.44

12" POPLAR S50°E 48.79

P.P. S59°W 66.02

18" OAK N35°W 32.79

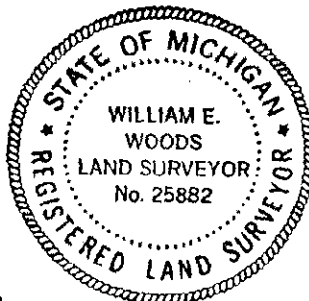

ACCEPTED BY THE IOSCO COUNTY SURVEY PEER GROUP AS THE OFFICIAL CORNER UNDER P.A. 845 OF 1990 AT A MEETING HELD ON 10-23-96

Signed by

William E Woods

Date

NOVEMBER 19, 1996

Surveyor's Michigan License No.

25882