

MAY 07 1957

IOSCO COUNTY REMONUMENTATION  
LAND CORNER RECORDATION CERTIFICATE  
Filing Requirement of Act 74, Mich. P.A. 1970

96-65

For corners in

IOSCO

(County)

Located In:

Corner Code #

1. Public Land Survey

T23NR9E

M.C. H-1 to I-1

T R

T R

T R

2. Property Controlling  
in Section

S

T R

S

T R

3. Miscellaneous  
Property in Sec.

S

T R

S

T R

STATE OF MICHIGAN  
IOSCO COUNTY  
FILED

6 DEC 96 2:10 P.M.

RONITA M. COYLE

Register of Deeds Stamp & File Number

4. Lot No. , Recorded Plat

5. Private Claims

I, WILLIAM E. WOODS in a field survey on NOV. 19 19 96 do hereby state that under requirements of P.A. 74, Michigan P.A. of 1970, the corner points mentioned in lines 1 and 2 above were in conformance with regulations and rules therefore as required in the current manual of survey instructions of the United States Department of the Interior, Bureau of Land Management or by a decree of a Court of Law and/or that the corner points mentioned in lines 3, 4 and 5 above were in conformance with the rules of the Michigan Board of Land Surveyors or by a Decree of a Court of Law; established, re-established, monumented, recovered, found as expressed below:

NOTE: Not more than 2 corners, all in the same town and range, may be recorded on this certificate.

	A	B	C	D	E	F	G	H	I	J	K	L	M
1													
2	6			5			4		3		2		1
3													
4	7			8			9		10		11		12
5													
6	18			17			16		15		14		13
7													
8	19			20			21		22		23		24
9													
10	30			29			28		27		26		25
11													
12	31			32			33		34		35		36
13													

A. Description of original monument and accessories and/or subsequent restoration:

1843: ORIGINAL GOVERNMENT SURVEY

48.78 SET POST

12" B-OAK N31°W 1.30

30" Y. PINE S13°W 3.57

1868: A. BRAKEMUDE

SHOWS THIS CORNER AS N.E. CORNER  
LOT 4 BLOCK 1, MAP OF VILLAGE OF  
OSCODA.

1

B. Description of corner evidence found and/or method applied in restoring or reestablishing corner:

1996: WILLIAM E. WOODS

ACCEPTED BY THE IOSCO COUNTY  
SURVEY PEER GROUP AS THE  
OFFICIAL CORNER UNDER P.A.  
345 OF 1990 AT A MEETING  
HELD ON 10-23-96

*James H. Chandler*

FOUND NO CORNER AT SHORE LINE  
MEANDER LOCATION WILL RE-ESTABLISH  
USING PLAT DATA.  
SET 5/8 BAR AND ALUMINUM CAP AT  
ORIGINAL GOVT. DISTANCE 579.48 FROM  
H-1 ON PLAT BOUNDARY LINE.

C. Description of monument for corner and accessories established to perpetuate locating the position of the corner:


5/8 BAR AND ALUMINUM CAP

NE CORNER HOUSE #205 S25°W 32.47

NW CORNER HOUSE #207 S54°E 31.32

20" WILLOW S78°W 23.38

15" OAK N18°W 50.01

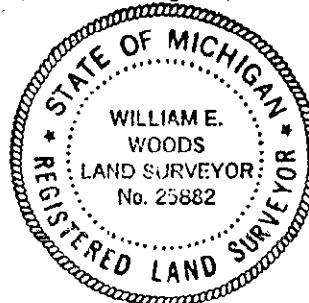

Signed by William E. Woods

Date NOVEMBER 19, 1996

Surveyor's Michigan License No. 25882