

SURVEY & REMONUMENTATION

FEB 21 2001

SECTION

LAND CORNER RECORDATION CERTIFICATE Filing Requirement of Act 74, Mich. P.A. 1970

COMMENCING YEAR 2000
RECEIVED FOR RECORD
IRON COUNTY, MICHIGAN

For corners in

Iron
(County)

Located In:

Corner Code #

1. Public Land Survey

T 43N R 31W

C.D-9w

T R

(009)

T R

T R

2. Property Controlling
in Section

S T R

S T R

3. Miscellaneous
Property in Sec.

S T R

S T R

00 DEC 22 PM 3:27
L.C. Records: L. 8, P. 319
Robert L. Pisoni
REGISTERED LAND SURVEYOR

Register of Deeds Stamp & File Number

4. Lot No. _____, Recorded Plat _____
5. Private Claims _____

West Meander Corner Between Sections 20 and 29, T43N, R31W

I, Gary L. Pisoni, in a field survey on December 1, 2000 do hereby state that under requirements of P.A. 74, Michigan P.A. of 1970, the corner points mentioned in lines 1 and 2 above were in conformance with regulations and rules therefore as required in the current manual of survey instructions of the United States Department of the Interior, Bureau of Land Management or by a decree of a Court of Law and /or that the corner points mentioned in lines 3, 4 and 5 above were in conformance with the rules of the Michigan Board of Land Surveyors or by a Decree of a Court of Law; established, re-established, monumented, recovered, found as expressed below:

NOTE: Not more than 2 corners, all in the same town and range, may be recorded on this certificate.

A. Description of original monument and accessories and/or subsequent restoration:

Original corner established on July 16, 1849 by John Burt, U.S. Deputy Surveyor.
Original Corner; 14" Spruce Meander Corner

B. Description of corner evidence found and/or method applied in restoring or reestablishing corner:

No evidence of original B.T.s found.

Found an old fence line running approximately West from top of river bank and said fence is 42' South of corner position.

Corner located on the West bank of the Michigamme River and is 10' from waters edge.

Restored the corner position by single proportionate measurement and set a witness corner meander corner on line between the Northwest Section corner and the North Quarter corner of Section 29.

Corner record research on file with County Representative.

C. Description of monument for corner and accessories established to perpetuate locating the position of the corner:

At the corner position, set a 5/8" diameter by 30" long rebar pin with a 3" diameter aluminum cap stamped as follows: Iron County Remonumentation, T43N, R31W, W.C.M.C., S- 20, S-29, N 89° 51'30"E, 4.94 feet, 2000, RLS 27457 from which I established the following new blazed and scribed bearing trees: (all measurements taken to a nail in side of tree)

Ash	5"	N 03° W	31.23 feet
Jack Pine	18"	S 02° E	41.71 feet
Jack Pine	11"	N 66° W	8.59 feet
Steel sign post		N 52° E	0.50 feet


00-087

Signed by Gary L. Pisoni

Date 12-19-2000

Surveyor's Michigan License No. 27457

FORM APPROVED BY MICHIGAN STATE BOARD OF PROFESSIONAL SURVEYORS, JAN 28, 1921

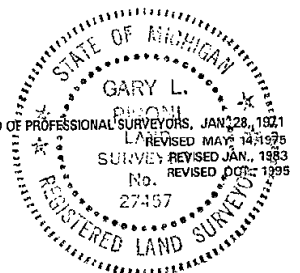

LIBER

8 PAGE 319