

LAND CORNER RECORDATION CERTIFICATE
Filing Requirement of Act 74, Mich. P.A. 1970

For corners in

Iron	Located In:	Corner Code #
(County)		
1. Public Land Survey	T 43N R 31W	J3
	T R	
	T R	
	T R	
2. Property Controlling in Section	S 2 T 43N R 31W	11
	S T R	
3. Miscellaneous Property in Sec.	S T R	
	S T R	

Register of Deeds Stamp & File Number

4. Lot No. _____, Recorded Plat _____
5. Private Claims _____

Jul 02 2002

I, Stephan J. Szyszkoski, in a field survey on _____, 20____ do hereby state that under requirements of P.A. 74, Michigan P.A. of 1970, the corner points mentioned in lines 1 and 2 above were in conformance with regulations and rules therefore as required in the current manual of survey instructions of the United States Department of the Interior, Bureau of Land Management or by a decree of a Court of Law and /or that the corner points mentioned in lines 3, 4 and 5 above were in conformance with the rules of the Michigan Board of Land Surveyors or by a Decree of a Court of Law; established, re-established, monumented, recovered, found as expressed below:

NOTE: Not more than 2 corners, all in the same town and range, may be recorded on this certificate.

	A	B	C	D	E	F	G	H	I	J	K	L	M
1													
2		6		5		4		3		2		1	
3													
4		7		8		9		10		11		12	
5													
6		18		17		16		15		14		13	
7													
8		19		20		21		22		23		24	
9													
10		30		29		28		27		26		25	
11													
12		31		32		33		34		35		36	
13													


A. Description of original monument and accessories and/or subsequent restoration:
(J3) Quarter corner common to Sections 2 & 11. 1849: Established by John Burt: " West True Line [between Sections 2 & 11]...39.96 Set Maple qr Sect. post. Cedar 10 N57E 14, Y.Birch 10 S34W 10...79.92 Section corner".
(11-Sec. 2) Southwest 1/16 corner, Section 2. Not established in the original survey. Found no subsequent record.

B. Description of corner evidence found and/or method applied in restoring or reestablishing corner:

(J3) The original post and accessories were not recovered. Found no evidence of the position of the original corner on the ground. Reestablished the corner midway and on a line of mean true bearing between Section corners 2635.93' east and west.
(11-Sec. 2) Established the corner at the intersection of straight lines connecting opposite 1/16 corners. From the corner thus established I found a 1/2" ID iron pipe, placed by persons unknown, N16E 16.5' distant, which I did not accept for the corner. Drove the 1/2" pipe to flush with the ground.

C. Description of monument for corner and accessories established to perpetuate locating the position of the corner:

(J3) Set 1"IDx32" I.pipe with 4" alum. MDNR cap. Blazed and scribed: 4" B.Ash North 37.6' "1/4S NBT" 5" B.Ash S24E 63.5' do 9" Cedar S19E 96.6' do 9" Cedar N15W 62.4' do Set sq'd cedar post adjacent. Bearings are magnetic. Distances to notch in lower blaze.	(11) Set 1"IDx32" I.pipe with 4" alum. MDNR cap. Blazed and scribed: 5" Sugar N50E 36.1' "1/16S BT" 11" Basswood S02W 43.5' do 7" Sugar S59W 44.3' do 12" Sugar N20W 27.6' do Set sq'd cedar post adjacent. Bearings are magnetic. Distances are to notch in lower blaze.
---	---

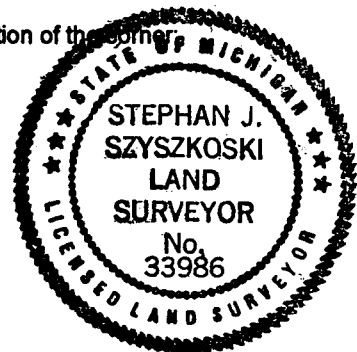

Signed by Stephan J. Szyszkoski
Surveyor's Michigan License No. 33986

Date 7/24/02

For the Michigan Department of Natural Resources - Office of Property Management

FORM APPROVED BY MICHIGAN STATE BOARD OF PROFESSIONAL SURVEYORS, JAN. 28, 1971

REVISED MAY 14, 1975

REVISED JAN., 1983

REVISED OCT., 1995