

PROPERTY &
RECORDS
MAR 9 2000

SECTION

LAND CORNER RECORDATION CERTIFICATE
Filing Requirement of Act 74, Mich. P.A. 1970

For corners in

	Iron (County)	Located In:	Corner Code #
1. Public Land Survey		T <u>43N</u> R <u>32W</u>	<u>LJ-7</u>
		T _____ R _____	<u>(001)</u>
		T _____ R _____	
		T _____ R _____	
2. Property Controlling in Section	S _____	T _____ R _____	
	S _____	T _____ R _____	
3. Miscellaneous	S _____	T _____ R _____	
Property in Sec.	S _____	T _____ R _____	

IRON COUNTY
MICHIGAN
RECEIVED FOR RECORD

99 DEC 30 AM 10:21

L.C. Records: L. J. P. 70
L. J. Pisoni
REGISTERED LAND SURVEYOR

Register of Deeds Stamp & File Number

4. Lot No. _____, Recorded Plat _____
5. Private Claims _____

West Meander Corner to Sections 14 and 23, T43N, R32W

I, Gary L. Pisoni, in a field survey on November 2, 1999 do hereby state that under requirements of P.A. 74, Michigan P.A. of 1970, the corner points mentioned in lines 1 and 2 above were in conformance with regulations and rules therefore as required in the current manual of survey instructions of the United States Department of the Interior, Bureau of Land Management or by a decree of a Court of Law and/or that the corner points mentioned in lines 3, 4 and 5 above were in conformance with the rules of the Michigan Board of Land Surveyors or by a Decree of a Court of Law; established, re-established, monumented, recovered, found as expressed below:

NOTE: Not more than 2 corners, all in the same town and range, may be recorded on this certificate.

	A	B	C	D	E	F	G	H	I	J	K	L	M
1													
2	6		5		4		3		2		1		
3													
4	7		8		9		10		11		12		
5													
6	18		17		16		15		14		13		
7													
8	19		20		21		22		23		24		
9													
10	30		29		28		27		26		25		
11													
12	31		32		33		34		35		36		
13													

A. Description of original monument and accessories and/or subsequent restoration:

Original corner established on August 4th, 1849 by Z. B. Searls, U.S. Deputy Surveyor.
Original Corner; Wood Post
Original Bearing Trees:
Spruce 4" S 14° 30' W 60 lks (39.60 feet)
Spruce 3" N 49° W 52 lks (34.32 feet)

PEER GROUP APPROVED
Iron County Rep 12-31-99
COUNTY REPRESENTATIVE

B. Description of corner evidence found and/or method applied in restoring or reestablishing corner:

No evidence of original B.T.s found.


Meander corner position restored on the West shore of Hope Lake and being on line between the Southwest and Southeast Section corners of Section 14. Monument is 4 feet from waters edge.

Corner record research on file with County Representative.

C. Description of monument for corner and accessories established to perpetuate locating the position of the corner:

At the corner position, set a 3/4" diameter aluminum rod monument, 3 feet long and 2" above ground surface with a 3" diameter aluminum cap stamped as follows: Iron County Remonumentation, T43N, R32W, M.C., S-14, S-23, 1999, RLS 27457 from which I established the following new blazed and scribed bearing trees: (All measurements taken to a nail in side of tree)

Tamarack	4"	S 36° E	48.50 feet
Black Spruce	5"	S 50° W	66.39 feet
Red Pine	6"	N 75° W	17.40 feet
Steel sign post		West	0.59 feet

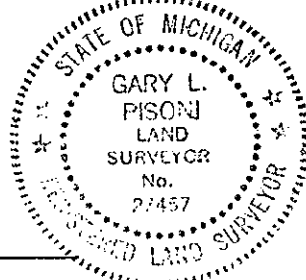

99-70
Signed by *Gary L. Pisoni* Date 12-28-99

Surveyor's Michigan License No. 27457

FORM APPROVED BY MICHIGAN STATE BOARD OF PROFESSIONAL SURVEYORS, JAN. 28, 1971
REVISED MAY 14, 1975
REVISED JAN., 1983
REVISED OCT., 1995