

1993

COMMISSION

LAND CORNER RECORDATION CERTIFICATE  
Filing Requirement of Act 74, Mich. P.A. 1970

IRON COUNTY  
MICHIGAN  
RECEIVED FOR RECORD

93 DEC 29 PM 2:22  
L.C. RECORDS L.C. P. 306

*Gilbert L. Pisoni*  
REGISTER OF DEEDS

For corners in

_____ Iron _____	Located In:	Corner Code #
(County)		
1. Public Land Survey	T 43N R 35W	H-9
	T _____ R _____	_____
	T _____ R _____	_____
	T _____ R _____	_____
2. Property Controlling	S _____ T _____ R _____	_____
in Section	S _____ T _____ R _____	_____
3. Miscellaneous	S _____ T _____ R _____	_____
Property in Sec.	S _____ T _____ R _____	_____

Register of Deeds Stamp & File Number

4. Lot No. \_\_\_\_\_, Recorded Plat \_\_\_\_\_  
5. Private Claims \_\_\_\_\_

Quarter Corner 22-27 T43N R35W

I, Gary L. Pisoni, in a field survey on December 21, 19 93, do hereby certify that under requirements of P.A. 74, Michigan P.A. of 1970, the corner points mentioned in lines 1 and 2 above were in conformance with regulations and rules therefore as required in the current manual of survey instructions of the United States Department of the Interior, Bureau of Land Management or by a decree of a Court of Law and/or that the corner points mentioned in lines 3, 4 and 5 above were in conformance with the rules of the Michigan Board of Land Surveyors or by a Decree of a Court of Law; established, re-established, monumented, re-monumented, recovered, found as expressed below:

NOTE: Not more than 4 corners, all in the same town and range, may be recorded on this certificate.

A. Description of original monument and accessories and/or subsequent restoration:

Original corner established by Harvey Mellen, U.S. Deputy Surveyor in 1851.

Original corner: Wood Post

Original bearing trees:

Cedar	14"	N 21° E	20 links (13.20 feet)
Cedar	12"	S 13° W	9 links ( 5.94 feet)

B. Description of corner evidence found and/or method applied in restoring or reestablishing corner:


No evidence of original corner or bearing tree remains. Corner position found marked by a 1" diameter iron pin encased in a concrete slab. Monument set by Iron Ore Companies in the 1950's.

This corner is accepted as the best available evidence of the position of the original corner.

C. Description of monument for corner and accessories established to perpetuate locating the position of the corner:

From the above corner monument, I established the following new corner references:  
( all measurements taken to a nail in side of tree, or to a reference object)

Popple	3"	N 59° E	5.69 feet
Popple	4"	S 74° E	7.17 feet
Rebar	5/8"x30"	S 10° W	16.73 feet
Rebar	5/8"x30"	N 54° W	13.43 feet
Steel Sign Post		N 84° E	2.40 feet

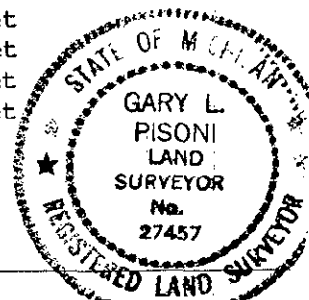

Signed by Gary L. Pisoni Date 12-28-93

Surveyor's Michigan License No. 27457