

SURVEY &  
REMONUMENTATION

JAN 12 1996

COMMISSION

LAND CORNER RECORDATION CERTIFICATE

Filing Requirement of Act 74, Mich. P.A. 1970

IRON COUNTY  
MICHIGAN  
RECEIVED FOR RECORD

95 DEC 15 PM 2:21

LC Records L. 6 P. 404

*Edith J. Stiehl*  
REGISTER OF DEEDS

For corners in

Iron  
(County)

Located In:

Corner Code #

1. Public Land Survey

T 43N R 34W A-3  
T 43N R 35W M-3 ✓  
T R  
T R

2. Property Controlling  
in Section

S T R  
S T R

3. Miscellaneous  
Property in Sec.

S T R  
S T R

Register of Deeds Stamp & File Number

4. Lot No. , Recorded Plat

5. Private Claims

Section Corner 1 & 12 T43N R35W  
6 & 7 T43N R34W

I, Gary L. Pisoni, in a field survey on October 12, 19 95,  
do hereby certify that under requirements of P.A. 74, Michigan P.A. of 1970, the corner points mentioned  
in lines 1 and 2 above were in conformance with regulations and rules therefore as required in the  
current manual of survey instructions of the United States Department of the Interior, Bureau of Land  
Management or by a decree of a Court of Law and/or that the corner points mentioned in lines 3, 4 and 5  
above were in conformance with the rules of the Michigan Board of Land Surveyors or by a Decree of a  
Court of Law; established, re-established, monumented, re-monumented, recovered, found as  
expressed below:

NOTE: Not more than 4 corners, all in the same town and range, may be recorded  
on this certificate.

A. Description of original monument and accessories and/or subsequent restoration:

Original corner established by William A. Burt, U.S. Deputy Surveyor in 1846.

Original corner: Fir Post

Original bearing trees:

White Pine	30"	S 60° E	22 links (14.52 feet)
White Pine	24"	N 08° W	19 links (12.54 feet)
White Pine	16"	S 26° W	26 links (17.16 feet)
Maple	10"	N 19½° E	30 links (19.80 feet)

B. Description of corner evidence found and/or method applied in restoring or reestablishing corner:

No original corner evidence found. Corner restored by single proportionate measurement  
methods on line between the Northwest corner of Section 6, T43N R34W and the West Quarter  
corner of Section 7, T43N R34W.

Corner falls in the corner of an old farm field. GLO distance along range line check good.

Research on file with County Representative.

C. Description of monument for corner and accessories established to perpetuate locating the position of the corner:

At the corner position, I set a 2" diameter by 30" long split base aluminum pipe  
monument with a 3" cast aluminum cap, stamped to read: Iron County Remonumentation,  
T43N, R35W, R34W, S-1, S-6, S-12, S-7, 1995, RLS- 27457 from which I established the  
following new blazed and scribed bearing trees: (all measurements taken to a nail  
in side of tree)


Black Spruce	8"	N 09° W	82.46 feet
Black Spruce	5"	N 59° W	107.78 feet
White Spruce	7"	S 57° W	137.04 feet
Steel Sign Post		South	0.85 feet

Signed by Gary L. Pisoni

Date 11-30-95

Surveyor's Michigan License No. 27457

PEER GROUP APPROVED  
Gary L. Pisoni 12-14-95  
COUNTY REPRESENTATIVE

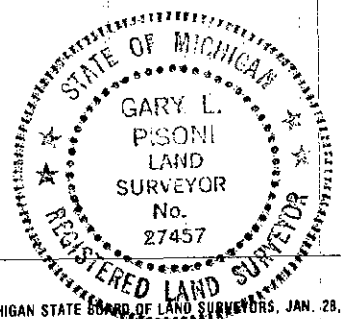

FORM APPROVED BY MICHIGAN STATE BOARD OF LAND SURVEYORS, JAN. 28, 1971  
REVISED MAY 14, 1975  
REVISED JAN. 1983