

LAND CORNER RECORDATION CERTIFICATE
Filing Requirement of Act 74, Mich. P.A. 1970

For corners in

Iron (County)	Located In:	Corner Code #
1. Public Land Survey	T 44N R 31E	14
	T R	
	T R	
	T R	
2. Property Controlling In Section	S 12 T R	18
	S T R	15
3. Miscellaneous Property in Sec.	S T R	16
	S T R	


10-10-83 (9/12)

Register of Deeds Stamp & File Number

4. Lot No. _____, Recorded Plat _____
 5. Private Claims _____

I, Keith Buckett, in a field survey on February 7, 19 89, do hereby certify that under requirements of P.A. 74, Michigan P.A. of 1970, the corner points mentioned in lines 1 and 2 above were in conformance with regulations and rules therefore as required in the current manual of survey instructions of the United States Department of the Interior, Bureau of Land Management or by a decree of a Court of Law and/or that the corner points mentioned in lines 3, 4 and 5 above were in conformance with the rules of the Michigan Board of Land Surveyors or by a Decree of a Court of Law; established, re-established, monumented, re-monumented, recovered, found as expressed below:

NOTE: Not more than 4 corners, all in the same town and range, may be recorded on this certificate.

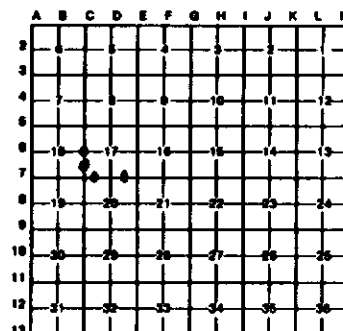

A. Description of original monument and accessories and/or subsequent restoration:

14	18	15	16
Original monument and accessories not found.	Not set on original survey nor subsequently, apparently.	Not set on original survey nor subsequently, apparently.	Not set on original survey nor subsequently, apparently.

B. Description of corner evidence found and/or method applied in restoring or reestablishing corner:

14	18	15	16
Restored midway and on line.	Established midway on line.	Established midway on line.	Established midway on line.

C. Description of monument for corner and accessories established to perpetuate locating the position of the corner:

14	18	15	16
Set 1" I.B. by 32" I.P. w/4" aluminum cap.	Set 1" I.B. by 32" I.P. w/4" aluminum cap.	Set 1" I.B. by 30" I.P. w/4" aluminum cap.	Set 1" I.B. by 30" I.P. w/4" aluminum cap.
6" sugar 116W 14.2' 1/16S NBT	14" oak 82WN 122.7' 1/16S BT	9" white pine 142E 46.8' 1/16S BT	6" maple 179W 10.5' 1/16S BT
6" sugar 94WN 19.5' 1/4S NBT	10" oak 87WN 146.7' 1/16S BT	BT	6" ash 120E 13.4' 1/16S BT
10" sugar 832E 7.7' 1/4S NBT		6" maple 843E 33.6' 1/16S BT	5" spruce 870E 17.8' 1/16S BT
square 6" sugar south 4.4'		7" maple 943N 23.3' 1/16S BT	3" balsam 824W 5.5' 1/16S BT

Signed by

Keith Buckett

Date

2/17/89

Surveyor's Michigan License No.

17806

FORM APPROVED BY MICHIGAN STATE BOARD OF LAND SURVEYORS, JAN. 30, 1971

