

SURVEY &
REMONUMENTATION

JAN 19 1999

SECTION

LAND CORNER RECORDATION CERTIFICATE
Filing Requirement of Act 74, Mich. P.A. 1970

For corners in

Iron (County) Located In: Corner Code #
1. Public Land Survey T 44N R 35W E-7
2. Property Controlling in Section S T R
3. Miscellaneous Property in Sec. S T R

IRON COUNTY MICHIGAN
RECEIVED FOR RECORD
98 DEC 28 AM 11:21
L.P. Records: L.P. P. 295
Register of Deeds Stamp & File Number

4. Lot No. , Recorded Plat
5. Private Claims

Section Corner Sections 16, 17, 20 and 21, T44N, R35W

I, Gary L. Pisoni, in a field survey on Dec. 1, 1998, do hereby state that under requirements of P.A. 74, Michigan P.A. of 1970, the corner points mentioned in lines 1 and 2 above were in conformance with regulations and rules therefore as required in the current manual of survey instructions of the United States Department of the Interior, Bureau of Land Management or by a decree of a Court of Law and/or that the corner points mentioned in lines 3, 4 and 5 above were in conformance with the rules of the Michigan Board of Land Surveyors or by a Decree of a Court of Law; established, re-established, monumented, recovered, found as expressed below:

Table with 13 rows and 13 columns (A-M) containing numerical data for survey points.

NOTE: Not more than 2 corners, all in the same town and range, may be recorded on this certificate.

A. Description of original monument and accessories and/or subsequent restoration:

Original corner established in September, 1851 by Harvey Mellen, Deputy Surveyor.
Original Corner; Wood Post
Original Bearing Trees:
Yellow Birch 18" N 52° E 17 links (11.22 feet)
Hemlock 12" N 66° W 39 links (25.74 feet)

On 6/24/69, Donald D. Lappala, RLS U.S.F.S., restored the corner position in the centerline of Gibbs City Road and in line with a wire fence line running East and West. He set a 3/4" diameter by 8" long galvanized iron pin in the centerline of said road with a reference monument being a 2" diameter by 5' long galvanized iron pipe with a 3" brass cap stamped as follows: T44N, R35W, R.M., S-16, S-17, S-20, S-21, East 29.42 feet, RLS 12585, 1969, 24" above ground surface recorded in L.C. Certificate Liber 3, Page 48 on 3/11/70.

1969 Bearing Tree:
Red Maple 7" N 75° W 93.2 feet
Yellow Birch 7" S 64° E 51.1 feet
Sugar Maple 18" S 59° W 95.0 feet

PE... APPROVED
Iron A. Pisoni 12-18-98
COUNTY REPRESENTATIVE

B. Description of corner evidence found and/or method applied in restoring or reestablishing corner:

No evidence of B.T.s found. Found monument as described above and the following bearing tree:

Yellow Birch 8" S 63° E 51.10 feet
R.M. 2" x 5' pipe West 29.50 feet

I accept the above monument as the best available evidence for restoring the corner position.
Corner record research on file with County Representative.


C. Description of monument for corner and accessories established to perpetuate locating the position of the corner:

Blazed and scribed the following new bearing trees: (All measurements taken to a nail in side of tree)

Maple 11" N 27° E 82.23 feet
Balsam 6" N 63° W 56.40 feet
Steel sign post West 30.40 feet

98-143
Signed by Gary L. Pisoni Date 12-21-98
Surveyor's Michigan License No. 27457

FORM APPROVED BY MICHIGAN STATE BOARD OF PROFESSIONAL SURVEYORS, JAN. 28, 1971
REVISOR, MAY 14, 1975
REVISOR, JAN., 1983
REVISOR, OCT., 1995

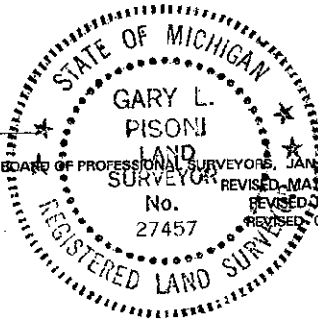

L.7 P. 295