

LAND CORNER RECORDATION CERTIFICATE
Filing Requirement of Act 74, Mich. P.A. 1970 as Amended

For corners in

Iron (County)	Located In:	Corner Code #
1. Public Land Survey	T _____ R _____ T _____ R _____ T _____ R _____	_____ _____ _____
2. Property Controlling in Section	S 8 T 45N R 31W S 8 T 45N R 31W S _____ T _____ R _____	1 14 _____ _____ _____
3. Miscellaneous Property in Sec.	S _____ T _____ R _____ S _____ T _____ R _____	_____ _____ _____ _____
4. Lot No. _____, Recorded Plat _____		
5. Private Claims _____		

Register of Deeds Stamp & File Number

	A	B	C	D	E	F	G	H	I	J	K	L	M
1													
2	6		5		4		3		2		1		
3													
4	7		8		9		10		11		12		
5													
6	16		17		16		15		14		13		
7													
8	19		20		21		22		23		24		
9													
10	30		29		28		27		26		25		
11													
12	31		32		33		34		35		36		
13													

I, Stephan J. Szyszkoski, in a field survey on 14 05/31/2011 do hereby state
that under requirements of P.A. 74, Michigan P.A. of 1970, the corner points mentioned in lines 1 and 2
above were in conformance with regulations and rules therefore as required in the current manual of survey
instructions of the United States Department of the Interior, Bureau of Land Management or by a decree of
a Court of Law and /or that the corner points mentioned in lines 3, 4 and 5 above were in conformance with
the rules of the Michigan Board of Land Surveyors or by a Decree of a Court of Law; established,
re-established, monumented, recovered, found as expressed below:

NOTE: Not more than 2 corners, all in the same town and range, may be recorded
on this certificate.

A. Description of original monument and accessories and/or subsequent restoration:

(1-Sec. 8) West 1/16 corner between Sections 5 and 8. Not established in the original survey.

(14-Sec. 8) South 1/16 corner between Sections 8 and 9. Not established in the original survey.
Found no subsequent record.

B. Description of corner evidence found and/or method applied in restoring or reestablishing corner:

(1-Sec. 8) Established the corner midway and on the Section line between Section corner 1326.80' west
and Quarter corner 1326.80' east.

(14-Sec. 8) Found a 5/8" rebar capped with a 2" dia. aluminum cap stamped "S1/16 8.9 LS No 12027"
0.06' west and 0.21' north of a position midway between Section and Quarter corners south and north,
respectively. Accepted same as a careful and faithful determination of the position of the corner.

C. Description of monument for corner and accessories established to perpetuate locating the position of the corner:


(1) Set 1"IDx32" I.pipe with 4" alum. MDNR cap.
Set measuring nail with MDNR tag in the side of:
8" B.Spruce S27E 9.4' mrkd "1/16S BT"
10" Cedar S30W 21.5' do
9" B.Spruce S63W 6.9' do
10" Cedar S72W 18.5' do
Set sq'd Cedar post adjacent.
Bearings are magnetic.

(14) Fd. 5/8" rebar with 2" alum. cap.
by Robert Perkins RLS 12027.
Set measuring nail with MDNR tag in the side of:
8" Sugar N35E 12.1' mrkd "1/16S BT"
5" Sugar S39W 18.3' do
4" Sugar N26W 8.8' do
5" Sugar S19E 32.8' do
Fd. older blazes on the first 3, above.
Bearings are magnetic. Set sq'd post adjacent.

Signed by Stephan J. Szyszkoski
Surveyor's Michigan License No. 33986

Date 08/03/2011

For the Michigan Department of Natural Resources, Forest Management Division

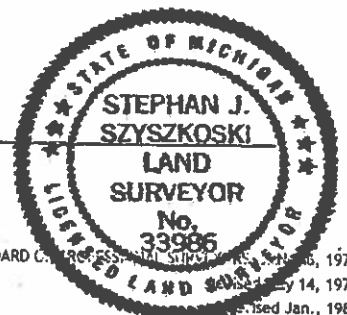

16682

16685

FORM APPROVED BY MICHIGAN STATE BOARD OF PROFESSIONAL SURVEYORS, 1971

Revised Jan., 1983

Revised Oct., 1995