

SURVEY & REMONUMENTATION

FORM NO. 985-A



Stock No. 26273

MAR 19 1997

COMMISSION

LAND CORNER RECORDATION CERTIFICATE

Filing Requirement of Act 74, Mich. P.A. 1970

For corners in

Iron
(County)

Located In:

Corner Code #

1. Public Land Survey

T 46N R 35W

M-11

T 46N R 34W

A-11

T R

T R

2. Property Controlling
in Section

S

T R

S

T R

3. Miscellaneous
Property in Sec.

S

T R

S

T R

4. Lot No. , Recorded Plat

5. Private Claims

Section Corner 25, T46N R35W, 30, T46N R34W
36, T46N R35W, 31, T46N R34W

Gary L. Pisoni, in a field survey on October 11, 1996 do hereby state that under requirements of P.A. 74, Michigan P.A. of 1970, the corner points mentioned in lines 1 and 2 above were in conformance with regulations and rules therefore as required in the current manual of survey instructions of the United States Department of the Interior, Bureau of Land Management or by a decree of a Court of Law and/or that the corner points mentioned in lines 3, 4 and 5 above were in conformance with the rules of the Michigan Board of Land Surveyors or by a Decree of a Court of Law; established, re-established, monumented, recovered, found as expressed below:

NOTE: Not more than 2 corners, all in the same town and range, may be recorded on this certificate.

A. Description of original monument and accessories and/or subsequent restoration:

Original corner established by William Burt, U.S. Deputy Surveyor on September 21, 1846.

Original corner: Sugar Post

Original bearing trees:

| | | | |
|---------|-----|---------|-----------------------|
| Hemlock | 12" | S 25° E | 28 links (18.48 feet) |
| Maple | 10" | N 24° W | 32 links (21.12 feet) |

Original Subdivision established by Zelotes B. Searls on July 10, 1852.

Original bearing tree:

| | | | |
|-------------|----|---------|----------------------|
| Sugar Maple | 8" | N 36° E | 8 links (5.28 feet) |
|-------------|----|---------|----------------------|

In 1965, Donald D. Lappala, R.L.S., set a 2" dia. X 5 feet long, concrete filled galvanized iron pipe with brass tablet from a found 3" x 3" cedar post and evidence from original bearing trees as described above.

Recorded in Land Corner Certificate L. 3, Page 214 on June 1, 1966.

1965 Bearing trees:

| | | | |
|--------------|----|---------|-----------|
| Sugar Maple | 2" | N 80° W | 18.6 feet |
| Yellow Birch | 3" | S 48° E | 42.5 feet |
| Yellow Birch | 4" | S 35° W | 24.1 feet |

Description of corner evidence found and/or method applied in restoring or reestablishing corner:

Found the monument and bearing trees as described above.

| | | | |
|----------------|----|---------|------------|
| Yellow Birch | 5" | S 50° E | 10.89 feet |
| Yellow Birch | 4" | S 35° W | 23.83 feet |
| Wood Sign Post | | N 49° W | 6.00 feet |

Corner Record Research on file with County Representative.

Description of monument for corner and accessories established to perpetuate locating the position of the corner:

At the above described brass cap monument, I established the following new blazed and scribed

bearing trees: (all measurements taken to a nail in side of tree)

| | | | |
|-----------------|-----|---------|------------|
| Hemlock | 16" | N 16° W | 35.18 feet |
| Sugar Maple | 8" | N 69° W | 43.71 feet |
| Steel Sign Post | 6' | S 65° W | 0.85 feet |

96-08

igned by Gary L. Pisoni

Date 12-10-96

urveyor's Michigan License No. 27457

FORM APPROVED BY MICHIGAN STATE BOARD OF PROFESSIONAL SURVEYORS, JAN. 28, 1971

REVISED MAY 14, 1975

REVISED JAN., 1983

REVISED OCT., 1995

IRON COUNTY
MICHIGAN
RECEIVED FOR RECORD

95 DEC 23 AM 8:57

L.C. Records: L. 7, P. 30

Gary L. Pisoni
REGISTERED DEEDS


Register of Deeds Stamp & File Number

| | A | B | C | D | E | F | G | H | I | J | K | L | M |
|----|----|---|----|---|----|---|----|---|----|---|----|---|---|
| 1 | | | | | | | | | | | | | |
| 2 | 6 | | 5 | | 4 | | 3 | | 2 | | 1 | | |
| 3 | | | | | | | | | | | | | |
| 4 | 7 | | 8 | | 9 | | 10 | | 11 | | 12 | | |
| 5 | | | | | | | | | | | | | |
| 6 | 18 | | 17 | | 16 | | 15 | | 14 | | 13 | | |
| 7 | | | | | | | | | | | | | |
| 8 | 19 | | 20 | | 21 | | 22 | | 23 | | 24 | | |
| 9 | | | | | | | | | | | | | |
| 10 | 30 | | 29 | | 28 | | 27 | | 26 | | 25 | | |
| 11 | | | | | | | | | | | | | |
| 12 | 31 | | 32 | | 33 | | 34 | | 35 | | 36 | | |
| 13 | | | | | | | | | | | | | |

PEER GROUP APPROVED

Iron Gary L. Pisoni 12-11-96

COUNTY REPRESENTATIVE

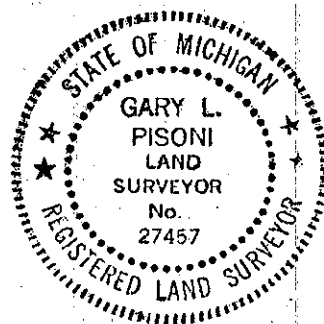

L. 7 P. 30