

SURVEY & REMONUMENTATION

FORM NO. 985-A



Stock No. 26273

MAR 19 1997

COMMISSION

LAND CORNER RECORDATION CERTIFICATE Filing Requirement of Act 74, Mich. P.A. 1970

For corners in

Iron
(County)

Located In:

Corner Code #

1. Public Land Survey

T 46N R 35W

K-13

T 45N R 35W

K-1

T R

T R

2. Property Controlling
in Section

S T R

S T R

3. Miscellaneous

S T R

Property in Sec.

S T R

4. Lot No. , Recorded Plat

5. Private Claims

Section Corner 35 & 36 T46N R35W
2 & 1 T45N R35W

I, Gary L. Pisoni, in a field survey on October 10, 1996 do hereby state that under requirements of P.A. 74, Michigan P.A. of 1970, the corner points mentioned in lines 1 and 2 above were in conformance with regulations and rules therefore as required in the current manual of survey instructions of the United States Department of the Interior, Bureau of Land Management or by a decree of a Court of Law and/or that the corner points mentioned in lines 3, 4 and 5 above were in conformance with the rules of the Michigan Board of Land Surveyors or by a Decree of a Court of Law; established, re-established, monumented, recovered, found as expressed below:

NOTE: Not more than 2 corners, all in the same town and range, may be recorded on this certificate.

A. Description of original monument and accessories and/or subsequent restoration:

Original corner established by William Burt, U.S. Deputy Surveyor in 1846.

Original corner: Wood Post

Original bearing trees:

Hemlock	10"	N 49° E	32 links (21.12 feet)
Yellow Birch	24"	N 11° W	32 links (21.12 feet)
Yellow Birch	14"	S 82° W	10 links (6.60 feet)
Maple	10"	S 58° E	37 links (24.42 feet)

In 1969, Donald D. Lappala, R.L.S. set a 2" dia. Concrete filled galvanized pipe with brass tablet from a found 4" x 4" Cedar post and evidence from original bearing trees as described above.

Recorded in Land Corner Certificate L. 3, Page 227 on June 5, 1969.

1969 Bearing Trees:

Sugar Maple	5"	N 43° W	15.1 feet
Yellow Birch	5"	S 72° E	25.0 feet
Sugar Maple	4"	S 15° E	16.0 feet

3. Description of corner evidence found and/or method applied in restoring or reestablishing corner:

Found the monument and bearing trees as described above:

Sugar Maple	8"	N 43° W	15.01 feet
Yellow Birch	12"	S 71° E	24.91 feet
Sugar Maple	5"	S 14° E	15.97 feet

Corner Record Research on file with County Representative.

2. Description of monument for corner and accessories established to perpetuate locating the position of the corner:

Blazed and scribed the following new bearing trees: (all measurements taken to a nail in side of tree)

Red Maple	8"	S 71° W	50.77 feet
Steel Sign Post	6'	North	0.70 feet

96-1

igned by Gary L. Pisoni

Date 12-10-96

urveyor's Michigan License No. 27457

FORM APPROVED BY MICHIGAN STATE BOARD OF PROFESSIONAL SURVEYORS, JAN. 28, 1971

REVISED MAY 14, 1975

REVISED JAN., 1983

REVISED OCT., 1995

IRON COUNTY
RECEIVED FOR RECORD

96 DEC 23 AM 8:50

L.C. Records L. 7, P. 23

Gailen L. Pisoni
REGISTERED DEEDS


Register of Deeds Stamp & File Number

	A	B	C	D	E	F	G	H	I	J	K	L	M
1													
2	6		5		4		3		2		1		
3													
4	7		8		9		10		11		12		
5													
6	18		17		16		15		14		13		
7													
8	19		20		21		22		23		24		
9													
10	30		29		28		27		26		25		
11													
12	31		32		33		34		35		36		

PEER GROUP APPROVED

Pisoni Gary L. Pisoni 12-1-96

COUNTY REPRESENTATIVE

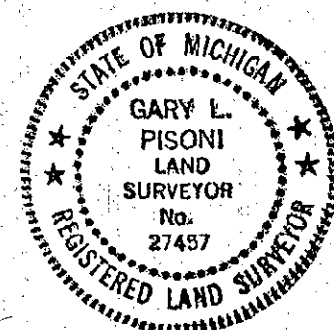

L. 7 P. 23