

LAND CORNER RECORDATION CERTIFICATE
Filing Requirement of Act 74, Mich. P.A. 1970
Isabella County Remonumentation

JAN 25 2000

For corners in

ISABELLA
(County)

Located In:

Corner Code #

199900012175

Filed for Record in
ISABELLA COUNTY, MI
SHARON A BROWN

SECTION

On 12-07-1999 At 09:50:26 am.
RE LAND COR 9.00
Liber 1 Page 310 - 310

1. Public Land Survey
INTERIOR 1/4 CORNER
SECTION 15

T 13N R 6W

H-6

T R

T R

T R

T R

2. Property Controlling
in Section

S T R

S T R

3. Miscellaneous
Property in Sec.

S T R

S T R

4. Lot No. , Recorded Plat

5. Private Claims

Register of Deeds Stamp & File Number

I, Timothy E. Bebee, in a field survey on December 1, 1999, do hereby state that under requirements of P.A. 74, Michigan P.A. of 1970, the corner points mentioned in lines 1 and 2 above were in conformance with regulations and rules therefore as required in the current manual of survey instructions of the United States Department of the Interior, Bureau of Land Management or by a decree of a Court of Law and/or that the corner points mentioned in lines 3, 4 and 5 above were in conformance with the rules of the Michigan Board of Land Surveyors or by a Decree of a Court of Law; established, re-established, monumented, recovered, found as expressed below:

NOTE: Not more than 2 corners, all in the same town and range, may be recorded on this certificate.


A. Description of original monument and accessories and/or subsequent restoration:

Not set by GLO

1882 J. Graham CS.....Set Black Ash stake 4x4

1976 J. Jones, PA 132.....Found pipe (L. 003, P. 16)

1986 W. Ruddell, LCRC, 817.....Found 3/4" pipe

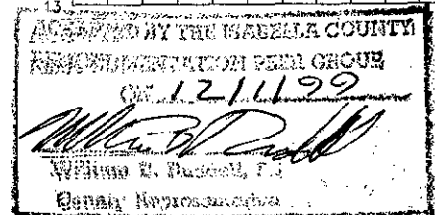

B. Description of corner evidence found and/or method applied in restoring or reestablishing corner:

Found 3/4" pipe in line with fence line to North, 6'± North of old road centerline, 28'± South of right of way fence to west. Measured 2633.17' to North 1/4 corner as compared to county surveyor notes, which measured 2633.40 in 1882. Also measured 2612.95 to East 1/4 corner as compared to 2613.60 measured during the same county survey. Found corner is 14.96' East and 4.24' North of mathematical intersection of North-South and East-West 1/4 lines. Excavated below found no other evidence. Accepted corner as the best available evidence of the perpetuated corner.

C. Description of monument for corner and accessories established to perpetuate locating the position of the corner:

A Remonumentation monument stamped #39074 was set at the position of the Corner and is accepted as the best available evidence of the perpetuated corner

Witnesses:

| | | |
|---------|--------|---|
| 65° AZ | 31.96' | Found Nail and Tag #14769 in 16" Red Maple. |
| 128° AZ | 39.37' | Found Nail and Tag #14769 in 6" Red Maple. |
| 188° AZ | 42.40' | Set Nail and Tag #17741 in 4" Red Maple. |
| 270° AZ | 0.85' | Found Nail and Tag #14769 in Fence post. |
| 283° AZ | 9.87' | Set Nail and Tag #17741 in 8" Red Maple. |



Signed by Timothy E. Bebee Date 12/1/99

Surveyor's Michigan License No. 39074